


1 LOCATION OF WATER WELL: Fraction NE 1/4 NE 1/4 SW 1/4 Section Number 33 Township Number T 11 S Range Number R 29 EW

Distance and direction from nearest town or city street address of well if located within city? 4S & 4 1/2 W OF GRAINFIELD

2 WATER WELL OWNER: NICHOLAS HEIER RR#, St. Address, Box #: P.O. BOX 237 Board of Agriculture, Division of Water Resources City, State, ZIP Code: GRAINFIELD, KS 67737 Application Number:

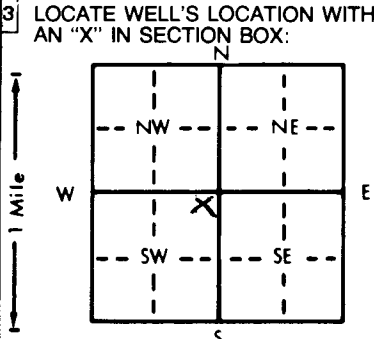

3 LOCATE WELL'S LOCATION WITH AN 'X' IN SECTION BOX: 4 DEPTH OF COMPLETED WELL: 117 ft. ELEVATION: WELL'S STATIC WATER LEVEL: 7.6 ft. below land surface measured on mo/day/yr

5 TYPE OF BLANK CASING USED: Steel, RMP (SR), PVC, ABS, Wrought iron, Asbestos-Cement, Concrete tile, Other (specify below), Fiberglass, CASING JOINTS: Glued, Clamped, Welded, Threaded. Blank casing diameter: 8 in. to 11.7 ft. Dia. Casing height above land surface: 10 in., weight lbs./ft. Wall thickness or gauge No. TYPE OF SCREEN OR PERFORATION MATERIAL: Steel, Stainless steel, Brass, Galvanized steel, Fiberglass, Concrete tile, RMP (SR), ABS, Other (specify). SCREEN OR PERFORATION OPENINGS ARE: Continuous slot, Mill slot, Louvered shutter, Key punched, Gauzed wrapped, Wire wrapped, Torch cut, Saw cut, Drilled holes, Other (specify). SCREEN-PERFORATED INTERVALS: GRAVEL PACK INTERVALS:

6 GROUT MATERIAL: Neat cement, Cement grout, Bentonite, Other. Grout intervals: What is the nearest source of possible contamination: Septic tank, Sewer lines, Watertight sewer lines, Lateral lines, Cess pool, Seepage pit, Pit privy, Sewage lagoon, Feedyard, Livestock pens, Fuel storage, Fertilizer storage, Insecticide storage, Abandoned water well, Oil well/Gas well, Other (specify below): NONE. Direction from well? How many feet?

Table with 6 columns: FROM, TO, LITHOLOGIC LOG, FROM, TO, PLUGGING INTERVALS. Row 1: 117, 160, Sand + Concrete the last 7 ft approx, X, DESCRIBE HOW PLUGGED.

7 CONTRACTOR'S OR LANDOWNER'S CERTIFICATION: This water well was (1) constructed, (2) reconstructed, or (3) plugged under my jurisdiction and was completed on (mo/day/year) and this record is true to the best of my knowledge and belief. Kansas Water Well Contractor's License No. This Water Well Record was completed on (mo/day/yr) Oct. 19, 1987 under the business name of by (signature) Nicholas Heier

OFFICE USE ONLY T R EW SEC. 1/4 1/4 1/4