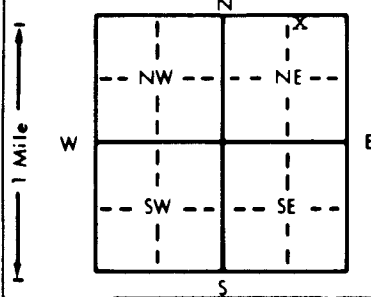


1 LOCATION OF WATER WELL: Fraction Section Number Township Number Range Number  
 County: OTTAWA NW 1/4 NE 1/4 NE 1/4 26 T 11 S R 3 EW

Distance and direction from nearest town or city street address of well if located within city?

3 MILES NORTH 1 1/4 WEST OF BENNINGTON, KS.

2 WATER WELL OWNER: LARRY DOYEN  
 RR#, St. Address, Box # P.O. BOX 85 Board of Agriculture, Division of Water Resources  
 City, State, ZIP Code CONCORDIA, KS. 66901 Application Number:

3 LOCATE WELL'S LOCATION WITH AN "X" IN SECTION BOX:  

 4 DEPTH OF COMPLETED WELL: 68 ft. ELEVATION:  
 Depth(s) Groundwater Encountered 1. 31 ft. 2. ft. 3. ft.  
 WELL'S STATIC WATER LEVEL 30.10 ft. below land surface measured on mo/day/yr 7-10-96  
 Pump test data: Well water was 33 ft. after 1 hours pumping 20 gpm  
 Est. Yield .75 gpm: Well water was ft. after hours pumping gpm  
 Bore Hole Diameter .9 in. to .69 ft., and in. to ft.  
 WELL WATER TO BE USED AS:  
 5 Public water supply 8 Air conditioning 11 Injection well  
 1 Domestic 3 Feedlot 6 Oil field water supply 9 Dewatering 12 Other (Specify below)  
 2 Irrigation 4 Industrial 7 Lawn and garden only 10 Monitoring well  
 Was a chemical/bacteriological sample submitted to Department? Yes No X If yes, mo/day/yr sample was submitted  
 Water Well Disinfected? Yes X No

5 TYPE OF BLANK CASING USED:  
 1 Steel 3 RMP (SR) 5 Wrought iron 8 Concrete tile CASING JOINTS: Glued X Clamped  
 2 PVC 4 ABS 6 Asbestos-Cement 9 Other (specify below) Welded  
 7 Fiberglass Threaded  
 Blank casing diameter 5 in. to 58 ft., Dia 160 in. to ft., Dia in. to SDR 26 ft.  
 Casing height above land surface 20 in., weight 160 lbs./ft. Wall thickness or gauge No.  
 TYPE OF SCREEN OR PERFORATION MATERIAL:  
 1 Steel 3 Stainless steel 5 Fiberglass 7 PVC 10 Asbestos-cement  
 2 Brass 4 Galvanized steel 6 Concrete tile 8 RMP (SR) 11 Other (specify)  
 9 ABS 12 None used (open hole)  
 SCREEN OR PERFORATION OPENINGS ARE:  
 1 Continuous slot 3 Mill slot .035 5 Gauzed wrapped 8 Saw cut 11 None (open hole)  
 2 Louvered shutter 4 Key punched 7 Torch cut 9 Drilled holes 10 Other (specify)  
 SCREEN-PERFORATED INTERVALS: From 58 ft. to 68 ft., From ft. to ft.  
 From ft. to ft., From ft. to ft.  
 GRAVEL PACK INTERVALS: From 53 ft. to 68 ft., From ft. to ft.  
 From ft. to ft., From ft. to ft.

6 GROUT MATERIAL: 1 Neat cement 2 Cement grout 3 Bentonite 4 Other  
 Grout Intervals: From 4 ft. to 30 ft., From 50 ft. to 53 ft., From ft. to ft.  
 What is the nearest source of possible contamination:  
 1 Septic tank 4 Lateral lines 7 Pit privy 10 Livestock pens 14 Abandoned water well  
 2 Sewer lines 5 Cess pool 8 Sewage lagoon 11 Fuel storage 15 Oil well/Gas well  
 3 Watertight sewer lines 6 Seepage pit 9 Feedyard 12 Fertilizer storage 16 Other (specify below)  
 13 Insecticide storage NONE APPARENT

Direction from well? How many feet?

FROM	TO	LITHOLOGIC LOG	FROM	TO	PLUGGING INTERVALS
0	2	TOP SOIL			
2	13	SAND COARSE BROWN			
13	20	SANDSTONE BROWN			
20	27	CLAY TAN SOFT			
27	68	SANDSTONE TAN TO BROWN			

7 CONTRACTOR'S OR LANDOWNER'S CERTIFICATION: This water well was (1) constructed, (2) reconstructed, or (3) plugged under my jurisdiction and was completed on (mo/day/year) 7-10-96 and this record is true to the best of my knowledge and belief. Kansas  
 Water Well Contractor's License No. 388 This Water Well Record was completed on (mo/day/yr) 7-10-96  
 under the business name of PESTINGER PUMP SERVICE by signature Paul Pestinger

INSTRUCTIONS: Use typewriter or ball point pen. PLEASE PRESS FIRMLY and PRINT clearly. Please fill in blanks, underline or circle the correct answers. Send top three copies to Kansas Department of Health and Environment, Bureau of Water, Topeka, Kansas 66620-0001. Telephone: 913-296-5545. Send one to WATER WELL OWNER and retain one for your records.