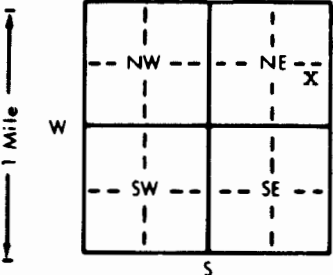


1 LOCATION OF WATER WELL: County: **OTTAWA** Fraction: **NE 1/4 SE 1/4 NE 1/4** Section Number: **24** Township Number: **T 11 S** Range Number: **R 3 EW**

Distance and direction from nearest town or city street address of well if located within city?

871 N. 180th

2 WATER WELL OWNER: **NORM MICK**
 RR#, St. Address, Box #: **P.O. BOX 136**
 City, State, ZIP Code: **MINNEAPOLIS, KS. 67467**
 Board of Agriculture, Division of Water Resources
 Application Number:

3 LOCATE WELL'S LOCATION WITH AN "X" IN SECTION BOX:


4 DEPTH OF COMPLETED WELL: **68.5** ft. ELEVATION:
 Depth(s) Groundwater Encountered 1. **25.1** ft. 2. ft. 3. ft.
 WELL'S STATIC WATER LEVEL: **25.1** ft. below land surface measured on **10-1-96**
 Pump test data: Well water was **28.2** ft. after **1** hours pumping **15** gpm
 Est. Yield **60** gpm: Well water was ft. after hours pumping gpm
 Bore Hole Diameter: **9** in. to **69** ft., and in. to ft.
 WELL WATER TO BE USED AS:
 1 Domestic 3 Feedlot 6 Oil field water supply 9 Dewatering 12 Other (Specify below)
 2 Irrigation 4 Industrial 7 Lawn and garden only 10 Monitoring well
 Was a chemical/bacteriological sample submitted to Department? Yes No **X**; If yes, mo/day/yr sample was submitted
 Water Well Disinfected? Yes **X** No

5 TYPE OF BLANK CASING USED:
 1 Steel 3 RMP (SR) 5 Wrought iron 8 Concrete tile CASING JOINTS: Glued **X** Clamped
 2 PVC 4 ABS 6 Asbestos-Cement 9 Other (specify below) Welded
 7 Fiberglass Threaded
 Blank casing diameter **5** in. to **58.5** ft. Dia. **160** in. to ft. Dia. in. to ft.
 Casing height above land surface **18** in. weight lbs./ft. Wall thickness or gauge No. **SDR 26**
 TYPE OF SCREEN OR PERFORATION MATERIAL:
 1 Steel 3 Stainless steel 5 Fiberglass 7 PVC 10 Asbestos-cement
 2 Brass 4 Galvanized steel 6 Concrete tile 8 RMP (SR) 11 Other (specify)
 9 ABS 12 None used (open hole)
 SCREEN OR PERFORATION OPENINGS ARE:
 1 Continuous slot 3 Mill slot **.035** 5 Gauzed wrapped 8 Saw cut 11 None (open hole)
 2 Louvered shutter 4 Key punched 7 Torch cut 9 Drilled holes 10 Other (specify)
 SCREEN-PERFORATED INTERVALS: From **58.5** ft. to **68.5** ft., From ft. to ft.
 GRAVEL PACK INTERVALS: From **50** ft. to **68.5** ft., From ft. to ft.
 From ft. to ft., From ft. to ft.

6 GROUT MATERIAL: 1 Neat cement 2 Cement grout 3 Bentonite 4 Other
 Grout intervals: From **6** ft. to **26** ft., From **47** ft. to **59** ft., From ft. to ft.
 What is the nearest source of possible contamination:
 1 Septic tank 4 Lateral lines 7 Pit privy 10 Livestock pens 14 Abandoned water well
 2 Sewer lines 5 Cess pool 8 Sewage lagoon 11 Fuel storage 15 Oil well/Gas well
 3 Watertight sewer lines 6 Seepage pit 9 Feedyard 12 Fertilizer storage 16 Other (specify below)
 13 Insecticide storage **OPEN PASTURE NONE APPARENT**
 Direction from well? How many feet?

FROM	TO	LITHOLOGIC LOG	FROM	TO	PLUGGING INTERVALS
0	2	TOP SOIL			
2	34	SANDSTONE REDISH BROWN			
34	69	SANDSTONE TAN			

7 CONTRACTOR'S OR LANDOWNER'S CERTIFICATION: This water well was (1) constructed, (2) reconstructed, or (3) plugged under my jurisdiction and was completed on (mo/day/year) **10-1-96** and this record is true to the best of my knowledge and belief. Kansas Water Well Contractor's License No. **388** This Water Well Record was completed on (mo/day/yr) **10-1-96** under the business name of **PESTINGER PUMP SERVICE** by (signature) *Paul P. Pester*

OFFICE USE ONLY
T
R
EAM
SEC.
1/4
1/4
1/4