


1 LOCATION OF WATER WELL: County: Ottawa	Fraction SW 1/4 NW 1/4 NE 1/4	Section Number 7	Township Number T 11 S	Range Number R 3 W
--	---	----------------------------	----------------------------------	---

Distance and direction from nearest town or city street address of well if located within city?

1/2 mile East of Minneapolis, KS

2 WATER WELL OWNER: Minneapolis Golf Course RR#, St. Address, Box # : 950 Laurel St. City, State, ZIP Code : Minneapolis, KS 67467	Backup - Well Board of Agriculture, Division of Water Resources Application Number: 44,439
---	--

3 LOCATE WELL'S LOCATION WITH AN "X" IN SECTION BOX:	4 DEPTH OF COMPLETED WELL: 85 ft. ELEVATION:	Depth(s) Groundwater Encountered 1. ft. 2. ft. 3. ft. WELL'S STATIC WATER LEVEL 55 ft. below land surface measured on mo/day/yr 3/23/01 Pump test data: Well water was 75 ft. after 3 hours pumping 110 gpm Est. Yield 100-125 gpm: Well water was ft. after hours pumping gpm Bore Hole Diameter 20 in. to 85 ft., and in. to ft. WELL WATER TO BE USED AS: 1 Domestic 3 Feedlot 6 Oil field water supply 9 Dewatering 12 Other (Specify below) <input checked="" type="checkbox"/> Irrigation 4 Industrial 7 Lawn and garden only 10 Monitoring well Was a chemical/bacteriological sample submitted to Department? Yes..... No <input checked="" type="checkbox"/>; If yes, mo/day/yr sample was submitted Water Well Disinfected? Yes <input checked="" type="checkbox"/> No
--	---	--

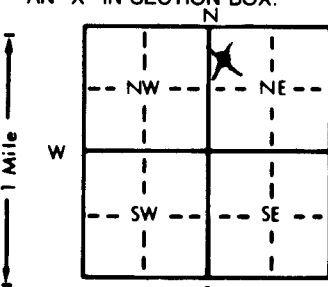

5 TYPE OF BLANK CASING USED: 1 Steel <input checked="" type="checkbox"/> PVC Blank casing diameter 10 in. to 45 ft., Dia Casing height above land surface 12 in., weight 8.878 lbs./ft. Wall thickness or gauge No. 413	5 Wrought iron 6 Asbestos-Cement 7 Fiberglass 8 Concrete tile 9 Other (specify below) CASING JOINTS: Glued <input checked="" type="checkbox"/> Clamped Welded Threaded	TYPE OF SCREEN OR PERFORATION MATERIAL: 1 Steel 3 Stainless steel 5 Fiberglass 8 RMP (SR) 10 Asbestos-cement 2 Brass 4 Galvanized steel 6 Concrete tile 9 ABS 11 Other (specify) 12 None used (open hole) SCREEN OR PERFORATION OPENINGS ARE: 1 Continuous slot <input checked="" type="checkbox"/> Mill slot 5 Gauzed wrapped 8 Saw cut 11 None (open hole) 2 Louvered shutter 4 Key punched 6 Wire wrapped 9 Drilled holes 7 Torch cut 10 Other (specify) SCREEN-PERFORATED INTERVALS: From 45 ft. to 85 ft., From ft. to ft. GRAVEL PACK INTERVALS: From 25 ft. to 85 ft., From ft. to ft.
--	---	--

6 GROUT MATERIAL: 1 Neat cement <input checked="" type="checkbox"/> Cement grout 3 Bentonite 4 Other Grout Intervals: From 2 ft. to 25 ft., From ft. to ft.	10 Livestock pens 14 Abandoned water well 11 Fuel storage 15 Oil well/Gas well 12 Fertilizer storage 16 Other (specify below) 13 Insecticide storage Direction from well? North How many feet? 300
--	--

FROM	TO	LITHOLOGIC LOG	FROM	TO	PLUGGING INTERVALS
0	3	Topsoil			
3	64	Soft Sandstone			
64	74	Hard Sandstone			
74	76	Yellow, gray Clay			
76	85	Hard sandstone			
85		Light gray shale			

7 CONTRACTOR'S OR LANDOWNER'S CERTIFICATION: This water well was (constructed, (2) reconstructed, or (3) plugged under my jurisdiction and was completed on (mo/day/year) **3/23/01** and this record is true to the best of my knowledge and belief. Kansas Water Well Contractor's License No. **138**. This Water Well Record was completed on (mo/day/yr) **3/27/01** under the business name of **Peterson Irrigation, Inc.** by (signature) *Michael Peterso*

OFFICE USE ONLY