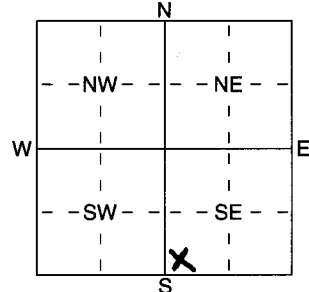


1 LOCATION OF WATER WELL: Fraction **SW 1/4 SW 1/4 SE 1/4** Section Number **6** Township Number **T 11 S** Range Number **R 3 SW**  
 County: **Ottawa**

Distance and direction from nearest town or city street address of well if located within city?

**City Limits, 246 S. First, Minneapolis, Ks.**

2 WATER WELL OWNER: **Max Marler**  
 RR#, St. Address, Box # : **246 S. First** Board of Agriculture, Division of Water Resources  
 City, State, ZIP Code : **Minneapolis, Ks. 67467** Application Number:

3 LOCATE WELL'S LOCATION WITH AN "X" IN SECTION BOX:  
  
 4 DEPTH OF COMPLETED WELL **140** ft. ELEVATION:  
 Depth(s) Groundwater Encountered 1 ..... ft. 2 ..... ft. 3 ..... ft.  
 WELL'S STATIC WATER LEVEL **70** ft. below land surface measured on mo/day/yr **3/1/05**  
 Pump test data: Well water was ..... ft. after ..... hours pumping ..... gpm  
 Est. Yield **30** gpm: Well water was ..... ft. after ..... hours pumping ..... gpm  
 WELL WATER TO BE USED AS:  
 5 Public water supply 8 Air conditioning 11 Injection well  
 1 Domestic 3 Feedlot 6 Oil field water supply 9 Dewatering 12 Other (Specify below)  
 2 Irrigation 4 Industrial **X** Domestic (lawn & garden) 10 Monitoring well .....  
 Was a chemical/bacteriological sample submitted to Department? Yes ..... No **X**.....; If yes, mo/day/yr sample was submitted  
 Water Well Disinfected? Yes **X** No

5 TYPE OF BLANK CASING USED:  
 1 Steel 3 RMP (SR) 5 Wrought iron 8 Concrete tile CASING JOINTS: Glued **X** Clamped .....  
**X** PVC 4 ABS 7 Fiberglass 9 Other (specify below) Welded .....  
 Blank casing diameter **5** in. to **130** ft., Dia ..... in. to ..... ft., Dia ..... in. to ..... ft.  
 Casing height above land surface **12** in., weight **2.37** lbs./ft. Wall thickness or guage No. **214**  
 TYPE OF SCREEN OR PERFORATION MATERIAL:  
 1 Steel 3 Stainless Steel 5 Fiberglass **X** PVC 10 Asbestos-Cement  
 2 Brass 4 Galvanized Steel 6 Concrete tile 8 RMP (SR) 11 Other (Specify) .....  
 9 ABS 12 None used (open hole)  
 SCREEN OR PERFORATION OPENINGS ARE:  
 1 Continuous slot **X** Mill slot 5 Guazed wrapped 8 Saw cut 11 None (open hole)  
 2 Louvered shutter 4 Key punched 6 Wire wrapped 9 Drilled holes  
 7 Torch cut 10 Other (specify) ..... ft.  
 SCREEN-PERFORATED INTERVALS: From **130** ft. to **140** ft., From ..... ft. to ..... ft.  
 GRAVEL PACK INTERVALS: From **20** ft. to **140** ft., From ..... ft. to ..... ft.

6 GROUT MATERIAL: 1 Neat cement 2 Cement grout **X** Bentonite 4 Other .....  
 Grout Intervals: From **0** ft. to **20** ft., From ..... ft. to ..... ft., From ..... ft. to ..... ft.  
 What is the nearest source of possible contamination:  
 1 Septic tank 4 Lateral lines 7 Pit privy 10 Livestock pens 14 Abandoned water well  
 2 Sewer lines 5 Cess pool 8 Sewage lagoon 11 Fuel storage 15 Oil well/Gas well  
**X** Watertight sewer lines 6 Seepage pit 9 Feedyard 12 Fertilizer storage 16 Other (specify below)  
 13 Insecticide storage .....  
 Direction from well? **South** How many feet? **80 ft.**

FROM	TO	LITHOLOGIC LOG	FROM	TO	PLUGGING INTERVALS
<b>0</b>	<b>3</b>	<b>Topsoil</b>			
<b>3</b>	<b>7</b>	<b>Clay, tan</b>			
<b>7</b>	<b>108</b>	<b>Sandstone</b>			
<b>108</b>	<b>109</b>	<b>Shale, gray</b>			
<b>109</b>	<b>140</b>	<b>Sandstone</b>			

7 CONTRACTOR'S OR LANDOWNER'S CERTIFICATION: This water well was **X** constructed, (2) reconstructed, or (3) plugged under my jurisdiction and was completed on (mo/day/year) **3/1/05** and this record is true to the best of my knowledge and belief. Kansas Water Well Contractor's Licence No **138** This Water Well Record was completed on (mo/day/yr) **3/4/05** under the business name of **Peterson Irrigation, Inc.** by (signature) *Mike Peters*