


1 LOCATION OF WATER WELL: County: Ottawa Fraction SW NE Section Number 29 Township Number T 11 S Range Number R 3 EW  
 Distance and direction from nearest town or city street address of well if located within city?  
3 miles south and 2 1/2 miles east of Minneapolis, KS.

2 WATER WELL OWNER: John Tibbits  
 RR#, St. Address, Box #: R. R. #2 Board of Agriculture, Division of Water Resources  
 City, State, ZIP Code: Minneapolis, KS. Application Number:

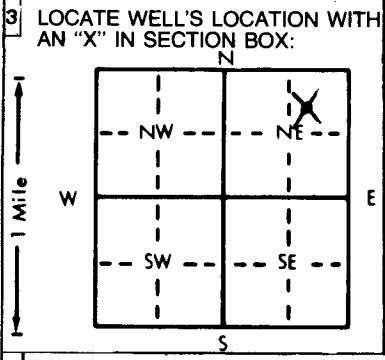

4 DEPTH OF COMPLETED WELL: 49 ft. ELEVATION:  
 Depth(s) Groundwater Encountered 1. 25 ft. 2. .... ft. 3. .... ft.  
 WELL'S STATIC WATER LEVEL: 23 ft. below land surface measured on mo/day/yr 11-17-82  
 Pump test data: Well water was .... ft. after .... hours pumping .... gpm  
 Est. Yield 30-50 gpm: Well water was .... ft. after .... hours pumping .... gpm  
 Bore Hole Diameter: 8 in. to 49 ft., and .... in. to .... ft.  
 WELL WATER TO BE USED AS:  
 Domestic 3 Feedlot 6 Oil field water supply 9 Dewatering 12 Other (Specify below)  
 2 Irrigation 4 Industrial 7 Lawn and garden only 10 Observation well STOCK  
 Was a chemical/bacteriological sample submitted to Department? Yes.....No. XX; If yes, mo/day/yr sample was submitted  
 Water Well Disinfected? Yes XX No

5 TYPE OF BLANK CASING USED:  
 1 Steel 3 RMP (SR) 5 Wrought iron 8 Concrete tile CASING JOINTS: Glued XX Clamped  
XX2 PVC 4 ABS 6 Asbestos-Cement 9 Other (specify below) Welded  
 7 Fiberglass Threaded  
 Blank casing diameter 5 in. to 39 ft., Dia. .... in. to .... ft., Dia. .... in. to .... ft.  
 Casing height above land surface: 12 in., weight 2.91 lbs./ft. Wall thickness or gauge No. 265  
 TYPE OF SCREEN OR PERFORATION MATERIAL: XX PVC 10 Asbestos-cement  
 1 Steel 3 Stainless steel 5 Fiberglass 8 RMP (SR) 11 Other (specify)  
 2 Brass 4 Galvanized steel 6 Concrete tile 9 ABS 12 None used (open hole)  
 SCREEN OR PERFORATION OPENINGS ARE:  
 1 Continuous slot XX3 Mill slot 5 Gauzed wrapped 8 Saw cut 11 None (open hole)  
 2 Louvered shutter 4 Key punched 6 Wire wrapped 9 Drilled holes  
 7 Torch cut 10 Other (specify)  
 SCREEN-PERFORATED INTERVALS: From 39 ft. to 49 ft., From .... ft. to .... ft.  
 From .... ft. to .... ft., From .... ft. to .... ft.  
 GRAVEL PACK INTERVALS: From 15 ft. to 49 ft., From .... ft. to .... ft.  
 From .... ft. to .... ft., From .... ft. to .... ft.

6 GROUT MATERIAL: XX1 Neat cement 2 Cement grout 3 Bentonite 4 Other  
 Grout Intervals: From 5 ft. to 15 ft., From .... ft. to .... ft., From .... ft. to .... ft.  
 What is the nearest source of possible contamination:  
 1 Septic tank 4 Lateral lines 7 Pit privy 10 Livestock pens 14 Abandoned water well  
 2 Sewer lines 5 Cess pool 8 Sewage lagoon 11 Fuel storage 15 Oil well/Gas well  
 3 Watertight sewer lines 6 Seepage pit XX9 Feedyard 12 Fertilizer storage 16 Other (specify below)  
 13 Insecticide storage  
 Direction from well? 3/4 mile south How many feet? 3/4 mile

FROM	TO	LITHOLOGIC LOG	FROM	TO	LITHOLOGIC LOG
0	5	Top soil			
5	18	Silty brown clay			
18	25	Brown clay			
25	36	Gray sandy clay			
36	44	Medium gray sand			
44	49	Coarse sand and gravel			
49	50	Gray shale			

7 CONTRACTOR'S OR LANDOWNER'S CERTIFICATION: This water well was (1) constructed, (2) reconstructed, or (3) plugged under my jurisdiction and was completed on (mo/day/year) 11-17-82 and this record is true to the best of my knowledge and belief. Kansas Water Well Contractor's License No. 138 This Water Well Record was completed on (mo/day/yr) 11-18-82 under the business name of Peterson Irrigation, Inc. by (signature) Mike Peterson

INSTRUCTIONS: Use typewriter or ball point pen, PLEASE PRESS FIRMLY and PRINT clearly. Please fill in blanks, underline or circle the correct answers. Send top three copies to Kansas Department of Health and Environment, Division of Environment, Environmental Geology Section, Topeka, KS 66620. Send one to WATER WELL OWNER and retain one for your records.

OFFICE USE ONLY  
T  
R  
3  
EW  
SEC. 29  
SW 1/4  
NE 1/4  
NE 1/4