


1 LOCATION OF WATER WELL:	Fraction	Section Number	Township Number	Range Number
County: <u>OTTAWA</u>	<u>NE</u> 1/4 <u>NE</u> 1/4 <u>NW</u> 1/4	<u>6</u>	T <u>11</u> S	R <u>23</u> EW

Distance and direction from nearest town or city street address of well if located within city?

1 MILE NORTH 1/2 MILE EAST OF BENNINGTON, KS.

2 WATER WELL OWNER: MARK WHITESELL	Board of Agriculture, Division of Water Resources
RR#, St. Address, Box #: 504 N. NELSON	Application Number:
City, State, ZIP Code: BENNINGTON, KS. 67422	

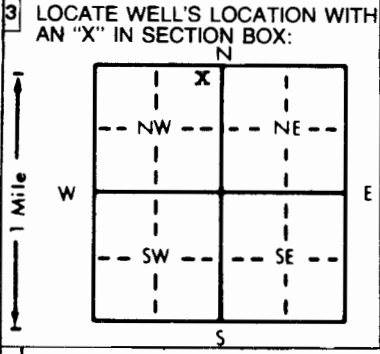

4 DEPTH OF COMPLETED WELL: <u>48.2</u> ft.	ELEVATION: <u>1232</u> ft.
Depth(s) Groundwater Encountered 1. <u>20.1</u> ft. 2. _____ ft. 3. _____ ft.	
WELL'S STATIC WATER LEVEL: <u>20.1</u> ft. below land surface measured on <u>1-26-95</u> mo/day/yr	
Pump test data: Well water was <u>22.5</u> ft. after <u>1</u> hours pumping <u>12</u> gpm	
Est. Yield: <u>25+</u> gpm; Well water was _____ ft. after _____ hours pumping _____ gpm	
Bore Hole Diameter: <u>9</u> in. to <u>488</u> ft., and _____ in. to _____ ft.	
WELL WATER TO BE USED AS:	
1 <u>Domestic</u>	2 Irrigation
3 Feedlot	4 Industrial
5 Public water supply	6 Oil field water supply
7 Lawn and garden only	8 Air conditioning
9 Dewatering	10 Monitoring well
11 Injection well	12 Other (Specify below)
Was a chemical/bacteriological sample submitted to Department? Yes _____ No <input checked="" type="checkbox"/> If yes, mo/day/yr sample was submitted _____	
Water Well Disinfected? Yes <input checked="" type="checkbox"/> No _____	

5 TYPE OF BLANK CASING USED:	5 Wrought iron	8 Concrete tile	CASING JOINTS: Glued <input checked="" type="checkbox"/> Clamped _____
1 Steel	3 RMP (SR)	6 Asbestos-Cement	9 Other (specify below)
<u>2 PVC</u>	4 ABS	7 Fiberglass	Welded _____
Blank casing diameter: <u>5</u> in. to <u>38</u> ft. Dia.			Threaded _____
Casing height above land surface: <u>20</u> in., weight <u>160</u> lbs./ft.			Wall thickness or gauge No. <u>SDR 26</u>
TYPE OF SCREEN OR PERFORATION MATERIAL:			
1 Steel	3 Stainless steel	5 Fiberglass	<u>7 PVC</u>
2 Brass	4 Galvanized steel	6 Concrete tile	8 RMP (SR)
SCREEN OR PERFORATION OPENINGS ARE:			
1 Continuous slot	<u>3 Mill slot .035</u>	5 Gauzed wrapped	8 Saw cut
2 Louvered shutter	4 Key punched	6 Wire wrapped	9 Drilled holes
SCREEN-PERFORATED INTERVALS:			
From <u>38</u> ft. to <u>48</u> ft.			
GRAVEL PACK INTERVALS:			
From <u>26</u> ft. to <u>48.2</u> ft.			

6 GROUT MATERIAL:	1 Neat cement	2 Cement grout	<u>3 Bentonite</u>	4 Other _____
Grout Intervals: From <u>2</u> ft. to <u>24</u> ft.				
What is the nearest source of possible contamination:				
1 Septic tank	4 Lateral lines	7 Pit privy	10 Livestock pens	14 Abandoned water well
2 Sewer lines	5 Cess pool	8 Sewage lagoon	11 Fuel storage	15 Oil well/Gas well
3 Watertight sewer lines	6 Seepage pit	9 Feedyard	12 Fertilizer storage	16 Other (specify below)
13 Insecticide storage OPEN FIELD NONE APPARENT				
Direction from well? _____ How many feet? _____				

FROM	TO	LITHOLOGIC LOG	FROM	TO	PLUGGING INTERVALS
0	2	TOP SOIL			
2	11	CLAY TAN HARD			
11	32	CLAY TAN SILTY AND SANDY			
32	48.2	SAND FINE TAN			
48.2		SHALE GRAY HARD			

7 CONTRACTOR'S OR LANDOWNER'S CERTIFICATION: This water well was (1) <u>constructed</u> , (2) reconstructed, or (3) plugged under my jurisdiction and was completed on (mo/day/year) <u>1-26-95</u> and this record is true to the best of my knowledge and belief. Kansas Water Well Contractor's License No. <u>388</u> This Water Well Record was completed on (mo/day/yr) <u>1-27-95</u> under the business name of PESTINGER PUMP SERVICE by signature <i>Paul Pestinger</i>
--