


1 LOCATION OF WATER WELL: Fraction 9W 1/4 SE 1/4 9W 1/4 Section Number 15 Township Number T 11 S Range Number R 30E
 County: Goose

Distance and direction from nearest town or city street address of well if located within city?
1.5 mi West of Grainfield

2 WATER WELL OWNER: Deans Estate
 RR#, St. Address, Box #: Richard Deans Board of Agriculture, Division of Water Resources
 City, State, ZIP Code: Grainfield KS Application Number:

3 LOCATE WELL'S LOCATION WITH AN "X" IN SECTION BOX:

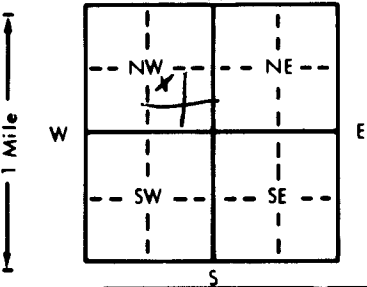

4 DEPTH OF COMPLETED WELL: 140 ft. ELEVATION: ft.
 Depth(s) Groundwater Encountered 1. 100 ft. 2. ft. 3. ft.
 WELL'S STATIC WATER LEVEL: 100 ft. below land surface measured on mo/day/yr
 Pump test data: Well water was ft. after hours pumping gpm
 Est. Yield 5 gpm: Well water was ft. after hours pumping gpm
 Bore Hole Diameter: 9 in. to 140 ft., and in. to ft.
 WELL WATER TO BE USED AS:
 Domestic 3 Feedlot 6 Oil field water supply 9 Dewatering 11 Injection well
 2 Irrigation 4 Industrial 7 Lawn and garden only 10 Observation well 12 Other (Specify below)
 Was a chemical/bacteriological sample submitted to Department? Yes.....No ; If yes, mo/day/yr sample was submitted
 Water Well Disinfected? Yes No

5 TYPE OF CASING USED:
 1 Steel 3 RMP (SR) 5 Wrought iron 8 Concrete tile CASING JOINTS: Glued Clamped
 PVC 4 ABS 7 Fiberglass Welded
 Blank casing diameter 5 in. to 140 ft., Dia in. to ft., Dia in. to ft.
 Casing height above land surface 9 in., weight 250 lbs./ft. Wall thickness or gauge No. 250

TYPE OF SCREEN OR PERFORATION MATERIAL:
 PVC 10 Asbestos-cement
 1 Steel 3 Stainless steel 5 Fiberglass 8 RMP (SR) 11 Other (specify)
 2 Brass 4 Galvanized steel 6 Concrete tile 9 ABS 12 None used (open hole)

SCREEN OR PERFORATION OPENINGS ARE:
 Continuous slot 3 Mill slot 5 Gauzed wrapped 8 Saw cut 11 None (open hole)
 2 Louvered shutter 4 Key punched 6 Wire wrapped 9 Drilled holes
 7 Torch cut 10 Other (specify)

SCREEN-PERFORATED INTERVALS: From 130 ft. to 140 ft., From ft. to ft.
 From ft. to ft., From ft. to ft.
 GRAVEL PACK INTERVALS: From 100 ft. to 140 ft., From ft. to ft.
 From ft. to ft., From ft. to ft.

6 GROUT MATERIAL: Neat cement 2 Cement grout 3 Bentonite 4 Other
 Grout intervals: From 0 ft. to 10 ft., From ft. to ft., From ft. to ft.

What is the nearest source of possible contamination:
 1 Septic tank 4 Lateral lines 7 Pit privy 10 Livestock pens 14 Abandoned water well
 2 Sewer lines 5 Cess pool 8 Sewage lagoon 11 Fuel storage 15 Oil well/Gas well
 3 Watertight sewer lines 6 Seepage pit 9 Feedyard 12 Fertilizer storage 16 Other (specify below) Draw
 13 Insecticide storage
 Direction from well? North How many feet? 1000

FROM	TO	LITHOLOGIC LOG	FROM	TO	LITHOLOGIC LOG
0	19	Topsoil			
19	36	Fine Sand			
36	51	m. Gravel			
51	70	Sandy Clay			
70	84	Fine Sand			
84	90	Sandy Clay			
90	106	Fine Sand			
106	113	m. Gravel			
113	120	m. Gravel			
120	136	Sandy Clay			
136	139	Sandstone			
139	140	Other			

7 CONTRACTOR'S OR LANDOWNER'S CERTIFICATION: This water well was constructed, (2) reconstructed, or (3) plugged under my jurisdiction and was completed on (mo/day/year) 4-25-86 and this record is true to the best of my knowledge and belief. Kansas
 Water Well Contractor's License No. 376 This Water Well Record was completed on (mo/day/yr) 6-86
 under the business name of B & B Drilling by (signature) Joseph Beckman

INSTRUCTIONS: Use typewriter or ball point pen, PLEASE PRESS FIRMLY and PRINT clearly. Please fill in blanks, underline or circle the correct answers. Send top three copies to Kansas Department of Health and Environment, Division of Environment, Environmental Geology Section, Topeka, KS 66620. Send one to WATER WELL OWNER and retain one for your records.

OFFICE USE ONLY
 T
 R
 EW
 SEC.
 1/4
 1/4
 1/4