


1 LOCATION OF WATER WELL: Fraction NE 1/4 NE 1/4 SE 1/4 Section Number 17 Township Number T 11 S Range Number R 30 W EW

Distance and direction from nearest town or city street address of well if located within city?  
N/A - LOCATION CONFIRMED BY GMD #4

2 WATER WELL OWNER: Lockwood Trust  
RR#, St. Address, Box # : c/o Richard A. Ball Board of Agriculture, Division of Water Resources  
City, State, ZIP Code : Great Bend, KS 67530 Application Number:

3 LOCATE WELL'S LOCATION WITH AN "X" IN SECTION BOX:

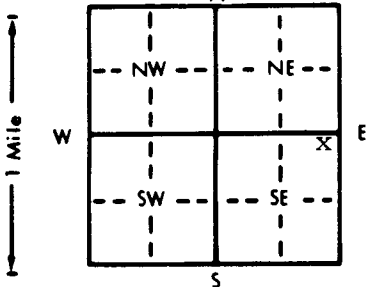

4 DEPTH OF COMPLETED WELL: UNKNOWN ft. ELEVATION: ...  
Depth(s) Groundwater Encountered 1. 0 ft. 2. ... ft. 3. ... ft.  
WELL'S STATIC WATER LEVEL DRY ... ft. below land surface measured on mo/day/yr  
Pump test data: Well water was ... ft. after ... hours pumping ... gpm  
Est. Yield ... gpm: Well water was ... ft. after ... hours pumping ... gpm  
Bore Hole Diameter ... in. to ... ft., and ... in. to ... ft.  
WELL WATER TO BE USED AS:  
X1 Domestic 3 Feedlot 6 Oil field water supply 9 Dewatering 12 Other (Specify below)  
2 Irrigation 4 Industrial 7 Lawn and garden only 10 Monitoring well  
Was a chemical/bacteriological sample submitted to Department? Yes ... No ...; If yes, mo/day/yr sample was submitted  
Water Well Disinfected? Yes No

5 TYPE OF BLANK CASING USED:  
X1 Steel 3 RMP (SR) 5 Wrought iron 8 Concrete tile CASING JOINTS: Glued ... Clamped ...  
2 PVC 4 ABS 6 Asbestos-Cement 9 Other (specify below) Welded ...  
Blank casing diameter 5 in. to ... ft., Dia ... in. to ... ft., Dia ... in. to ... ft.  
Casing height above land surface 0 in., weight ... lbs./ft. Wall thickness or gauge No. ...  
TYPE OF SCREEN OR PERFORATION MATERIAL:  
1 Steel 3 Stainless steel 5 Fiberglass 8 RMP (SR) 10 Asbestos-cement  
2 Brass 4 Galvanized steel 6 Concrete tile 9 ABS 12 None used (open hole)  
SCREEN OR PERFORATION OPENINGS ARE:  
1 Continuous slot 3 Mill slot 5 Gauzed wrapped 8 Saw cut 11 None (open hole)  
2 Louvered shutter 4 Key punched 6 Wire wrapped 9 Drilled holes  
SCREEN-PERFORATED INTERVALS: From ... ft. to ... ft., From ... ft. to ... ft.  
GRAVEL PACK INTERVALS: From ... ft. to ... ft., From ... ft. to ... ft.

6 GROUT MATERIAL: Neat cement Cement grout 3 Bentonite 4 Other  
Grout Intervals: From ... ft. to ... ft., From ... ft. to ... ft., From ... ft. to ... ft.  
What is the nearest source of possible contamination:  
1 Septic tank 4 Lateral lines 7 Pit privy 10 Livestock pens 14 Abandoned water well  
2 Sewer lines 5 Cess pool 8 Sewage lagoon 11 Fuel storage 15 Oil well/Gas well  
3 Watertight sewer lines 6 Seepage pit 9 Feedyard 12 Fertilizer storage 16 Other (specify below) DRAW  
Direction from well? West How many feet? 500

FROM	TO	LITHOLOGIC LOG	FROM	TO	PLUGGING INTERVALS
	ENTER		80	20	NATURAL EARTH MATERIAL
			20	0	CEMENT GROUT
		PLUGGING			
		INFORMATION			
		AT			
		RIGHT			

7 CONTRACTOR'S OR LANDOWNER'S CERTIFICATION: This water well was (1) constructed, (2) reconstructed, or (3) plugged under my jurisdiction and was completed on (mo/day/year) 6-1-89 and this record is true to the best of my knowledge and belief. Kansas  
Water Well Contractor's License No. 376 This Water Well Record was completed on (mo/day/yr) 6-23-89  
under the business name of B+B Drilling by (signature) Joseph Beckman

OFFICE USE ONLY  
T  
R  
EW  
SEC.  
1/4  
1/4  
1/4