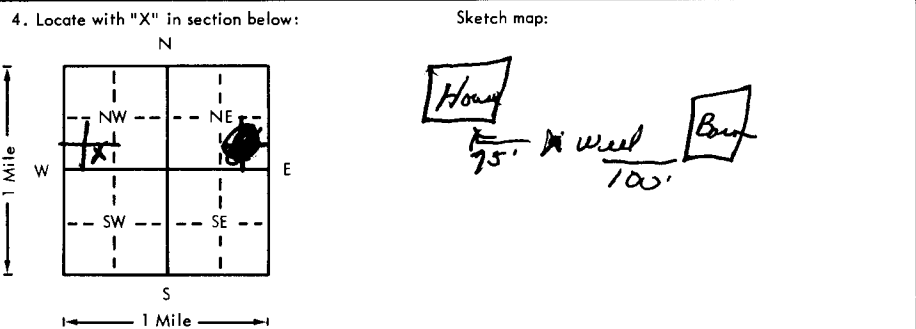


USE TYPEWRITER OR BALL POINT PEN-PRESS FIRMLY, PRINT CLEARLY.

WATER WELL RECORD
KSA 82a-1201-1215

Kansas Department of Health and Environment-Division of Environment
(Water well Contractors)
Topeka, Kansas 66620

1. Location of well: County <u>Shoene</u> Fraction <u>50^E 1/4 SW 1/4 NW 1/4</u> Section number <u>20</u> Township number T <u>11</u> S R <u>30</u> E <u>20</u>	
2. Distance and direction from nearest town or city: Street address of well location if in city: <u>1.5 3/4 W 1/4 S. of Shinnell</u>	
3. Owner of well: <u>Burtha Prew</u> R.R. or street: <u>Shinnell</u> City, state, zip code: <u>Shinnell, KS</u>	
4. Locate with "X" in section below: Sketch map: 	
6. Bore hole dia. <u>9</u> in. Completion date <u>6-3-80</u> Well depth <u>138</u> ft.	
7. <input checked="" type="checkbox"/> Cable tool <input checked="" type="checkbox"/> Rotary <input type="checkbox"/> Driven <input type="checkbox"/> Dug <input type="checkbox"/> Hollow rod <input type="checkbox"/> Jetted <input type="checkbox"/> Bored <input type="checkbox"/> Reverse rotary	
8. Use: <input checked="" type="checkbox"/> Domestic <input type="checkbox"/> Public supply <input type="checkbox"/> Industry <input type="checkbox"/> Irrigation <input type="checkbox"/> Air conditioning <input type="checkbox"/> Stock <input type="checkbox"/> Lawn <input type="checkbox"/> Oil field water <input type="checkbox"/> Other	
9. Casing: Material <input type="checkbox"/> Threaded <input type="checkbox"/> Welded <input type="checkbox"/> RMP <input type="checkbox"/> PVC <input checked="" type="checkbox"/> Height: Above or below Surface <u>12</u> in. Weight <u>200</u> lbs./ft. Dia. <u>8</u> in. to <u>159</u> ft. depth Wall Thickness: inches or Dia. <u>8</u> in. to <u>159</u> ft. depth gage No. <u>20074</u>	
5. Type and color of material	
10. Screen: Manufacturer's name <u>John Lovell</u> Type <u>PVC</u> Dia. <u>5"</u> Slot/gauze <u>1/8-7/16</u> Length <u>9'</u> Set between <u>120</u> ft. and <u>138</u> ft. Gravel pack? <input checked="" type="checkbox"/> Size range of material <u>1/4-1/2</u>	
11. Static water level: <u>95</u> ft. below land surface Date <u>6-3-80</u> mo./day/yr.	
12. Pumping level below land surfaces: <u>30</u> g.p.m. Estimated maximum yield <u>30</u> g.p.m.	
13. Water sample submitted: <input checked="" type="checkbox"/> Yes <input type="checkbox"/> No Date _____ mo./day/yr.	
14. Well head completion: <input checked="" type="checkbox"/> Pitless adapter <u>12</u> inches above grade <input checked="" type="checkbox"/> Well grouted? <input checked="" type="checkbox"/> With: <input type="checkbox"/> Neat cement <input checked="" type="checkbox"/> Bentonite <input type="checkbox"/> Concrete Depth: From <u>4</u> ft. to <u>14</u> ft.	
16. Nearest source of possible contamination: ft. <u>200</u> Direction <u>W</u> Type <u>Bonzal</u> Well disinfected upon completion? <input checked="" type="checkbox"/> Yes <input type="checkbox"/> No	
17. Pump: Not installed Manufacturer's name <u>Stouffer</u> Model number <u>13EM</u> HP <u>1</u> Volts <u>230</u> Length of drop pipe <u>110</u> ft. capacity <u>13</u> g.p.m. Type: <input checked="" type="checkbox"/> Submersible <input type="checkbox"/> Turbine <input type="checkbox"/> Jet <input type="checkbox"/> Reciprocating <input type="checkbox"/> Centrifugal <input type="checkbox"/> Other	
(Use a second sheet if needed)	
18. Elevation: Topography: <input type="checkbox"/> Hill <input type="checkbox"/> Slope <input checked="" type="checkbox"/> Upland <input type="checkbox"/> Valley	19. Remarks:
20. Water well contractor's certification: This well was drilled under my jurisdiction and this report is true to the best of my knowledge and belief. Business name <u>B+B Drillers</u> License No. <u>376</u> Address <u>Shinnell, KS</u> Signed <u>Joseph Biedman</u> Date <u>6-16-80</u> Authorized representative	

T 11 R 30 E 20 S SW 1/4

Forward the white, blue and pink copies to the Department of Health and Environment

Form WWC-5