


CORRECTED

WATER WELL RECORD Form WANC-5 KSA 82a-1212

1 LOCATION OF WATER WELL: County: **GOVS** Fraction: **SE 1/4 NE 1/4 NE 1/4** Section Number: **17** Township Number: **T 11 S** Range Number: **R 30 E**

2 WATER WELL OWNER: ~~Richard Lockwood~~ **CASTLE Resources, Inc**
 RFD, St. Address, Box #: **P.O. Box 583** Board of Agriculture, Division of Water Resources
 City, State, ZIP Code: **Great Bend, KS 67530** **Russell, KS 67665** Application Number: **20030049**

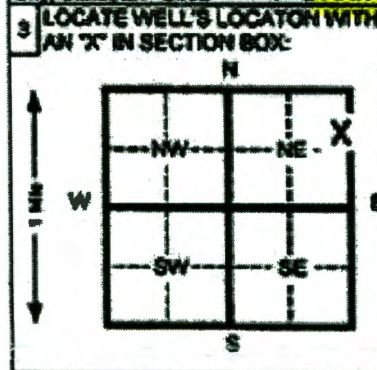

4 DEPTH OF COMPLETED WELL: **148** ft. ELEVATION: _____

Depth(s) Groundwater Encountered: 1 _____ ft. 2 _____ ft. 3 _____ ft.

WELL'S STATIC WATER LEVEL: **118** ft. below land surface measured on mo/day/yr _____

Pump test data: Well water was _____ ft. after _____ hours pumping _____ gpm

Est. Yield _____ gpm: Well water was _____ ft. after _____ hours pumping _____ gpm

Bore Hole Diameter: **8** in. to **180** ft. and _____ in. to _____ ft.

WELL WATER TO BE USED AS: 5 Public water supply 6 Air conditioning 11 Injection well

1 Domestic 3 Feed lot 6 Oil field water supply 9 Dewatering 12 Other (Specify below)

2 Irrigation 4 Industrial 7 Lawn and garden (domestic) 10 Monitoring well

Was a chemical/bacteriological sample submitted to Department? Yes _____ No If yes, mo/day/yr sample was submitted _____

Water Well Disinfected? Yes _____ No

5 TYPE OF BLANK CASING USED:

1 Steel 3 RMP (SR) 5 Wrought Iron 6 Concrete tile CASING JOINTS: Glued Clamped _____

2 PVC 4 ABS 7 Fiberglass 8 Asbestos-Cement 9 Other (specify below) Welded _____

Blank casing diameter: **4.5** in. to **108** ft. Dia _____ in. to _____ ft. Dia _____ in. to _____ ft.

Casing height above land surface: **18** in. weight **2.38** lbs./ft. Wall thickness or gauge No. **248**

TYPE OF SCREEN OR PERFORATION MATERIAL:

1 Steel 3 Stainless steel 5 Fiberglass 7 PVC 10 Asbestos-cement

2 Brass 4 Galvanized steel 6 Concrete tile 8 RMP (SR) 9 ABS 11 Other (specify) _____

SCREEN OR PERFORATION OPENINGS ARE:

1 Continuous slot 3 Mill slot 5 Gauzed wrapped 8 Sew cut 11 None (open hole)

2 Louvered shutter 4 Key punched 6 Wire wrapped 9 Drilled holes

7 Torch cut 10 Other (specify) _____

SCREEN-PERFORATED INTERVALS: From **108** ft. to **148** ft. From _____ ft. to _____ ft.

GRAVEL PACK INTERVALS: From **20** ft. to **148** ft. From _____ ft. to _____ ft.

6 GROUT MATERIAL: 1 Neat cement 2 Cement grout 3 Bentonite 4 Other _____

Grout intervals From **0** ft. to **20** ft. From _____ ft. to _____ ft.

What is the nearest source of possible contamination:

1 Septic tank 4 Lateral lines 7 Pit privy 10 Livestock pens 14 Abandoned water well

2 Sewer lines 5 Cess pool 8 Sewage lagoon 11 Fuel storage 15 Oil well/ Gas well

3 Watertight sewer lines 6 Seepage pit 9 Feedyard 12 Fertilizer storage 16 Other (specify below)

13 Insecticide storage NONE

Direction from well? _____ How many feet? _____

| FROM | TO | CODE | LITHOLOGIC LOG | FROM | TO | PLUGGING INTERVALS |
|------|-----|------|---------------------------------|------|----|--------------------|
| 0 | 2 | | Surface | | | |
| 2 | 10 | | Loess | | | |
| 10 | 35 | | Clay | | | |
| 35 | 50 | | Fine to med sand & caliche strk | | | |
| 50 | 57 | | Sandstone w/clay strks | | | |
| 57 | 70 | | Fine to med sand w/clay lens | | | |
| 70 | 87 | | Clay w/ few sand strks | | | |
| 87 | 112 | | Fine to med sand | | | |
| 112 | 121 | | Clay & caliche w/gravel strks | | | |
| 121 | 141 | | Clay | | | |
| 141 | 148 | | Fine sand w/lots of clay | | | |
| 148 | 180 | | Black shale | | | |

7 CONTRACTOR'S OR LANDOWNER'S CERTIFICATION: This water well was (1) constructed, (2) reconstructed, or (3) plugged under my jurisdiction and was completed on (mo/day/yr) **3-21-08** and this record is true to the best of my knowledge and belief. Kansas Water Well Contractor's License No. **554** This Water Well Record was completed on (mo/day/yr) **3-21-03** under the business name of **Woofter Pump and Well Inc.** by (signature) _____

INSTRUCTIONS: Please fill in blanks and circle the correct answers. Send three copies to Kansas Department of Health and Environment, Bureau of Wells, Topeka.



ASSIGNMENT OF WATER WELL TO LANDOWNER*
FORM WWC-7

Kevin P. Lockwood and Kenton B. Lockwood 206 Cardinal Lane
I, Co-Trustees of Lockwood Irrevocable Trust No. 1 of _____
(Landowner) (Landowner address)

Great Bend, KS 67530 am the landowner on which a water well is located in the
(City) (State)

1/4, SE 1/4, NE 1/4, NE 1/4, Section 17, Township 11 S, Range 30 E/W, in
Gove County, Kansas, and approximately 4380 feet N/S, and 100 feet E/W

of the apparent SE section corner. The water well was drilled in 3/2003 (month/year).

Trek AEC, LLC, current operator of oil and gas lease.

The water well was originally permitted to Castle Resources, Inc.

I hereby request that _____ leave the water well,
(Well operator/owner name)

which was drilled under Temporary/Term Water Permit # 20030049, unplugged, and I will assume all responsibility for properly maintaining said water well in accordance with the requirements of KDHE regulations in K.A.R. 28-30-6 to 28-30-10, including requesting and maintaining said well in inactive status and proper plugging when it is abandoned, in accordance with regulations in K.A.R. 28-30-7.

LANDOWNER:

WELL OWNER:

Kevin P. Lockwood - trustee
(Signature) (Date) 23 DEC 2020
Kevin P. Lockwood
KEVIN P. LOCKWOOD
(Print)

Kevin P. Lockwood - trustee 23 DEC 2020
(Signature) (Date)
By: Kevin P. Lockwood
(Agent)

IF ADDITIONAL LANDOWNER

Kenton B. Lockwood trustee
(Signature) (Date) 23 Dec 2020
Kenton B. Lockwood
(Print)

*Where the owner of a water well is not the landowner, KDHE regulations in Article 30 [K.A.R. 28-30-7(e)] allow responsibility for the well to be conveyed to the landowner in lieu of abandoning and plugging the well, but the well must conform to the requirements for active or inactive status. The transfer must be made through a legal document, approved by KDHE, advising the landowner of their responsibilities and obligations to properly maintain the well, including the proper plugging of the well when it is abandoned.

Landowners may obtain KDHE's written approval to maintain the well in an inactive status, in accordance with K.A.R. 28-30-7(f), rather than plugging it if the landowner can present evidence as to the well's condition and the landowner's intentions to use the well in the future.

A request for inactive water well status must be submitted to KDHE by completing Form WWC-6 in accordance with Procedure WWP-4. KDHE Water Well Program statutes, regulations, forms, and procedures are available at:
<http://www.kdheks.gov/waterwell/index.html>.

RECEIVED
JAN 8 2021
BUREAU OF WATER