


1	LOCATION OF WATER WELL:	Fraction	Section Number	Township Number	Range Number
	County: Gove	NE ¼ NE ¼ SE ¼	10	11 S	30 E W

Distance and direction from nearest town or city street address of well if located within city?
SW of I-70 at Exit 85, Grinnell

2	WATER WELL OWNER: Stuckey's	Board of Agriculture, Division of Water Resources
	RR #, St. Address, Box #: PO Box 102A	Application Number:
	City, State, ZIP Code: Grinnell, KS 67738	

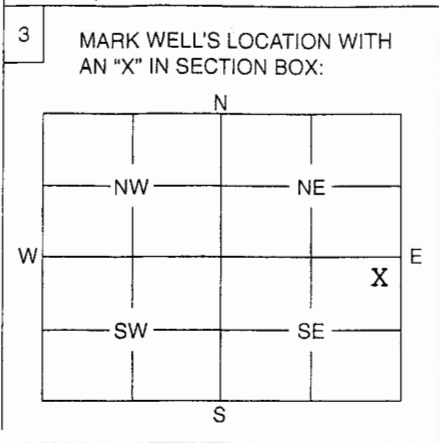

4 DEPTH OF WELL**107**..... ft.

WELL'S STATIC WATER LEVEL**85.95**..... ft.

WELL WAS USED AS:

1 Domestic	5 Public Water Supply	9 Dewatering
2 Irrigation	6 Oil Field Water Supply	<input checked="" type="radio"/> 10 Monitoring Well
3 Feedlot	7 Domestic (Lawn & Garden)	11 Injection Well
4 Industrial	8 Air Conditioning	12 Other

Was a chemical / bacteriological sample submitted to Department? Yes No

If yes, mo/day/yr sample was submitted

Water Well Disinfected: Yes No

5 TYPE OF BLANK CASING USED:

1 Steel	3 RMP (SR)	5 Wrought	7 Fiberglass	9 Other (Specify below)
<input checked="" type="radio"/> 2 PVC	4 ABS	6 Asbestos-Cement	8 Concrete Tile	

Blank casing diameter**4**..... in. Was casing pulled? Yes No

Casing height above or below land surface**n/a**..... in. If yes, how much **Overdrilled to 3'**

6 GROUT PLUG MATERIAL: 1 Neat cement 2 Cement grout 3 Bentonite 4 Other **Native soil**

Grout Plug Intervals: From**0**..... ft. to**2**..... ft., From**2**..... ft. to**107**..... ft., From to ft.

What is the nearest source of possible contamination:

1 Septic tank	6 Seepage pit	<input checked="" type="radio"/> 11 Fuel storage	16 Other (specify below)
2 Sewer lines	7 Pit privy	12 Fertilizer storage	
3 Watertight sewer lines	8 Sewage lagoon	13 Insecticide storage	
4 Lateral lines	9 Feedyard	14 Abandoned water well	
5 Cess pool	10 Livestock pens	15 Oil well/Gas well	

Direction from well? How many feet?

FROM	TO	PLUGGING MATERIALS
0	2	Native soil (11")
2	3	Bentonite (11")
3	107	Bentonite (4")

MW11

GeoCore #780

7 CONTRACTOR'S OF LANDOWNER'S CERTIFICATION: This water well was plugged under my jurisdiction and was completed on (mo/day/year) **8/11/2005** and this record is true to the best of my knowledge and belief. Kansas Water Well Contractor's License No. **527** This Water Well Record was completed on (mo/day/year) **8/17/2005** under the business name of **GeoCore, Inc.**

by (signature) *Don Holt*

INSTRUCTIONS: Use typewriter or ball point pen. Please press firmly and print clearly. Please fill in blanks, underline or circle the correct answers. Send top three copies to Kansas Department of Health and Environment, Bureau of Water, Geology Section, 1000 SW Jackson St., Ste. 420, Topeka, Kansas 66612-1367. Telephone: 785/296-5522. Send one to Water Well Owner and retain one for your records.