


1 LOCATION OF WATER WELL: Fraction Section Number Township Number Range Number
 County: Gove NE 1/4 NE 1/4 SE 1/4 10 11 S 30 E/W

Distance and direction from nearest town or city street address of well if located within city?
 SW of I-70 at Exit 85, Grinnell

2 WATER WELL OWNER: Stuckey's
 RR #, St. Address, Box #: PO Box 102A
 City, State, ZIP Code : Grinnell, KS 67738
 Board of Agriculture, Division of Water Resources
 Application Number:

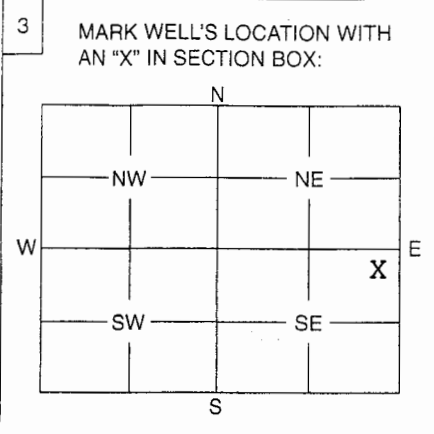

4 DEPTH OF WELL 105 ft.
 WELL'S STATIC WATER LEVEL 86.75 ft.
 WELL WAS USED AS:
 1 Domestic 2 Irrigation 3 Feedlot 4 Industrial 5 Public Water Supply 6 Oil Field Water Supply 7 Domestic (Lawn & Garden) 8 Air Conditioning 9 Dewatering 10 Monitoring Well 11 Injection Well 12 Other
 Was a chemical / bacteriological sample submitted to Department? Yes No X
 If yes, mo/day/yr sample was submitted
 Water Well Disinfected: Yes No X

5 TYPE OF BLANK CASING USED:
 1 Steel 2 PVC 3 RMP (SR) 4 ABS 5 Wrought 6 Asbestos-Cement 7 Fiberglass 8 Concrete Tile 9 Other (Specify below)
 Blank casing diameter 4 in. Was casing pulled? Yes No X If yes, how much Overdrilled to 3'
 Casing height above or below land surface n/a in.

6 GROUT PLUG MATERIAL: 1 Neat cement 2 Cement grout 3 Bentonite 4 Other Native soil
 Grout Plug Intervals: From 0 ft. to 2 ft., From 2 ft. to 105 ft., From to ft.
 What is the nearest source of possible contamination:
 1 Septic tank 2 Sewer lines 3 Watertight sewer lines 4 Lateral lines 5 Cess pool 6 Seepage pit 7 Pit privy 8 Sewage lagoon 9 Feedyard 10 Livestock pens 11 Fuel storage 12 Fertilizer storage 13 Insecticide storage 14 Abandoned water well 15 Oil well/Gas well 16 Other (specify below)
 Direction from well? How many feet?

FROM	TO	PLUGGING MATERIALS
0	2	Native soil (11")
2	3	Bentonite (11")
3	105	Bentonite (4")

MW13

GeoCore #780

7 CONTRACTOR'S OF LANDOWNER'S CERTIFICATION: This water well was plugged under my jurisdiction and was completed on (mo/day/year) 8/11/2005 and this record is true to the best of my knowledge and belief. Kansas Water Well Contractor's License No. 527 This Water Well Record was completed on (mo/day/year) 8/17/2005 under the business name of GeoCore Inc.
 by (signature) *Dale Robb*

INSTRUCTIONS: Use typewriter or ball point pen. Please press firmly and print clearly. Please fill in blanks, underline or circle the correct answers. Send top three copies to Kansas Department of Health and Environment, Bureau of Water, Geology Section, 1000 SW Jackson St., Ste. 420, Topeka, Kansas 66612-1367. Telephone: 785/296-5522. Send one to Water Well Owner and retain one for your records.