


WATER WELL RECORD Form WWC-5 KSA 82a-1212

1 LOCATION OF WATER WELL: Fraction NE 1/4 NE 1/4 SE 1/4 Section Number 10 Township Number T 11 S Range Number R 30 E/W

Distance and direction from nearest town or city street address of well if located within city? South to I - 70 Exit 85, Grinnell, Kansas

2 WATER WELL OWNER: Fred Miller RR#, St. Address, Box #: P.O. Box 301, 924 College St. Board of Agriculture, Division of Water Resources City, State, ZIP Code: Eastman, Georgia 31023 Application Number:

3 LOCATE WELL'S LOCATION WITH AN "X" IN SECTION BOX:

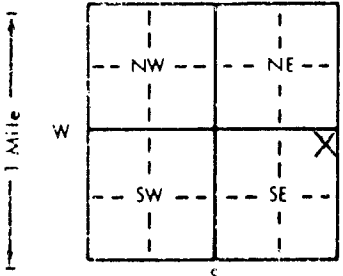

4 DEPTH OF COMPLETED WELL: 107 ft. ELEVATION: NA Depth(s) Groundwater Encountered: NA Wells' Static Water Level: NA Pump test data: Est. Yield: Bore Hole Diameter: 8 in. to 113 in. WELL WATER TO BE USED AS: 10 Monitoring well Was a chemical/bacteriological sample submitted to Department? Yes... No... X

5 TYPE OF BLANK CASING USED: 2 PVC Blank casing diameter: 4 in. to 77 ft. Dia Casing height above land surface: 24 in., weight lbs./ft. Wall thickness or gauge No. sch. 40 CASING JOINTS: Glued, Clamped, Welded, Threaded X

TYPE OF SCREEN OR PERFORATION MATERIAL: 7 PVC SCREEN OR PERFORATION OPENINGS ARE: 3 Mill slot SCREEN-PERFORATED INTERVALS: From 77 ft. to 107 ft. GRAVEL PACK INTERVALS: From 73 ft. to 113 ft.

6 GROUT MATERIAL: 2 Cement grout 3 Bentonite Grout Intervals: From 0 ft. to 64 ft. From 64 ft. to 73 ft. What is the nearest source of possible contamination: 11 Fuel storage Direction from well? Northwest How many feet? 125

Table with columns: FROM, TO, LITHOLOGIC LOG, FROM, TO, PLUGGING INTERVALS. Rows show depths from 0 to 113 feet with lithology: Cly. brn, Snd, v f - c/f grvl, Cly. lt brn, Snd, f - c/f - c grvl. MW8 - Aboveground

7 CONTRACTOR'S OR LANDOWNER'S CERTIFICATION: This water well was (11) constructed, (2) reconstructed, or (3) plugged under my jurisdiction and was completed on (mo/day/year) 08-01-94 and this record is true to the best of my knowledge and belief. Kansas Water Well Contractor's License No. 527 This Water Well Record was completed on (mo/day/yr) 08-12-94 under the business name of GeoCore Services, Inc by (signature)

INSTRUCTIONS: Use typewriter or ball point pen. PLEASE PRESS FIRMLY and PRINT clearly Please fill in blanks, underline or circle the correct answers. Send top three copies to Kansas Department of Health and Environment, Bureau of Water, Topeka, Kansas 66620-0001. Telephone: 913-296-5545. Send one to WATER WELL OWNER and retain one for your records.