


1 LOCATION OF WATER WELL: County: Gove Fraction: NE 1/4 NE 1/4 SE 1/4 Section Number: 10 Township Number: T 11 S Range Number: R 30 B/W

Distance and direction from nearest town or city street address of well if located within city? South fo I - 70 Exit 85, Grinnell, Kansas

2 WATER WELL OWNER: Fred Miller RR#, St. Address, Box #: P.O. Box 301, 924 College St. Board of Agriculture, Division of Water Resources City, State, ZIP Code: Eastman, Georgia 31023 Application Number:

3 LOCATE WELL'S LOCATION WITH AN "X" IN SECTION BOX:

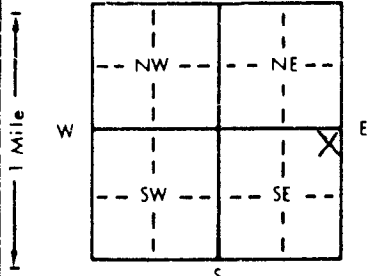

4 DEPTH OF COMPLETED WELL: 104 ft. ELEVATION: NA ft. WELL'S STATIC WATER LEVEL: 90.71 ft. below TOC measured on mo/day/yr Pump test data: Well water was ... gpm Est. Yield ... gpm Bore Hole Diameter: 8 in. to 105 ft. WELL WATER TO BE USED AS: 10 Monitoring well

5 TYPE OF BLANK CASING USED: 2 PVC 5 Wrought iron 8 Concrete tile 6 Asbestos-Cement 9 Other (specify below) 7 Fiberglass CASING JOINTS: Glued, Clamped, Welded, Threaded (X)

TYPE OF SCREEN OR PERFORATION MATERIAL: 7 PVC 10 Asbestos-cement 1 Steel 3 Stainless steel 5 Fiberglass 8 RMP (SR) 11 Other (specify) 2 Brass 4 Galvanized steel 6 Concrete tile 9 ABS 12 None used (open hole)

SCREEN OR PERFORATION OPENINGS ARE: 3 Mill slot 5 Gauzed wrapped 8 Saw cut 11 None (open hole) 1 Continuous slot 6 Wire wrapped 9 Drilled holes 2 Louvered shutter 4 Key punched 7 Torch cut 10 Other (specify)

SCREEN-PERFORATED INTERVALS: From 79 ft. to 104 ft. GRAVEL PACK INTERVALS: From 76 ft. to 105 ft.

6 GROUT MATERIAL: 2 Cement grout 3 Bentonite 4 Other Grout Intervals: From 0 ft. to 70 ft. From 70 ft. to 76 ft.

What is the nearest source of possible contamination: 11 Fuel storage 14 Abandoned water well 15 Oil well/Gas well 16 Other (specify below)

Direction from well? South How many feet? 75

Table with columns: FROM, TO, LITHOLOGIC LOG, FROM, TO, PLUGGING INTERVALS. Rows include lithologic logs like 'Cly, brown', 'Snd, v f - c/f grv' and a note 'M7 - Aboveground'.

7 CONTRACTOR'S OR LANDOWNER'S CERTIFICATION: This water well was (1) constructed, (2) reconstructed, or (3) plugged under my jurisdiction and was completed on (mo/day/year) 08-02-94 and this record is true to the best of my knowledge and belief. Kansas Water Well Contractor's License No. 527 This Water Well Record was completed on (mo/day/yr) 08-12-94 under the business name of GeoCore Services, Inc by (signature)