


1 LOCATION OF WATER WELL: Fraction SW 1/4 NW 1/4 SW 1/4 Section Number 30 Township Number T 11 S Range Number R 31 EW  
 County: GOVE

Distance and direction from nearest town or city street address of well if located within city?  
SS 2E OF OAKLEY

2 WATER WELL OWNER: HENRY ENGEL  
 RR#, St. Address, Box #: 415 CHERRY Board of Agriculture, Division of Water Resources  
 City, State, ZIP Code: OAKLEY, KS 67248 Application Number:

3 LOCATE WELL'S LOCATION WITH AN "X" IN SECTION BOX:

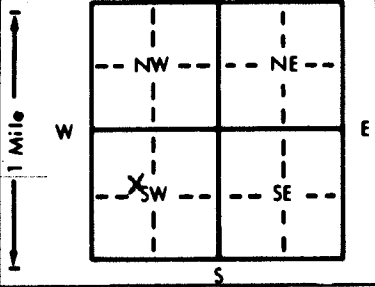

4 DEPTH OF COMPLETED WELL: X 25 ft. ELEVATION:

Depth(s) Groundwater Encountered 1. .... ft. 2. .... ft. 3. .... ft.  
 WELL'S STATIC WATER LEVEL DRY .... ft. below land surface measured on mo/day/yr  
 Pump test data: Well water was .... ft. after .... hours pumping .... gpm  
 Est. Yield .... gpm: Well water was .... ft. after .... hours pumping .... gpm  
 Bore Hole Diameter .... in. to .... ft., and .... in. to .... ft.  
 WELL WATER TO BE USED AS:  
 Domestic    3 Feedlot    6 Oil field water supply    9 Dewatering    12 Other (Specify below)  
 Irrigation    4 Industrial    7 Lawn and garden only    10 Monitoring well  
 Was a chemical/bacteriological sample submitted to Department? Yes.....No.....; If yes, mo/day/yr sample was submitted

5 TYPE OF BLANK CASING USED:  
 Steel    3 RMP (SR)    6 Asbestos-Cement    9 Other (specify below)    Welded .....  
 PVC    4 ABS    7 Fiberglass    .....    Threaded.....  
 Blank casing diameter S ..... in. to ..... ft., Dia ..... in. to ..... ft., Dia ..... in. to ..... ft.  
 Casing height above land surface ..... in., weight ..... lbs./ft. Wall thickness or gauge No. ....

TYPE OF SCREEN OR PERFORATION MATERIAL:  
 Steel    3 Stainless steel    5 Fiberglass    8 RMP (SR)    11 Other (specify) .....  
 Brass    4 Galvanized steel    6 Concrete tile    9 ABS    12 None used (open hole)

SCREEN OR PERFORATION OPENINGS ARE:  
 Continuous slot    3 Mill slot    6 Wire wrapped    9 Drilled holes  
 Louvered shutter    4 Key punched    7 Torch cut    10 Other (specify) .....

SCREEN-PERFORATED INTERVALS: From ..... ft. to ..... ft., From ..... ft. to ..... ft.  
 GRAVEL PACK INTERVALS: From ..... ft. to ..... ft., From ..... ft. to ..... ft.

6 GROUT MATERIAL: 1 Neat cement    2 Cement grout    3 Bentonite    4 Other .....  
 Grout intervals: From ..... ft. to ..... ft., From ..... ft. to ..... ft., From ..... ft. to ..... ft.

What is the nearest source of possible contamination:  
 Septic tank    4 Lateral lines    7 Pit privy    10 Livestock pens    14 Abandoned water well  
 Sewer lines    5 Cess pool    8 Sewage lagoon    11 Fuel storage    15 Oil well/Gas well  
 Watertight sewer lines    6 Seepage pit    9 Feedyard    12 Fertilizer storage     Other (specify below)  
NONE

Direction from well? How many feet?

FROM	TO	LITHOLOGIC LOG	FROM	TO	PLUGGING INTERVALS
				X	DESCRIBE PLUGGING
					Sand to about 10 ft then cement to about 2 ft and then dirt.
			25	10	Sand
			10	2	cement
			2	0	dirt

7 CONTRACTOR'S OR LANDOWNER'S CERTIFICATION: This water well was (1) constructed, (2) reconstructed, or  plugged under my jurisdiction and was completed on (mo/day/year) X ..... and this record is true to the best of my knowledge and belief. Kansas Water Well Contractor's License No. .... This Water Well Record was completed on (mo/day/yr) X 2 November 1988 under the business name of ..... by (signature) X Henry Engel

OFFICE USE ONLY  
T  
R  
EW  
SEC.