


1 LOCATION OF WATER WELL: Fraction NE 1/4 NE 1/4 NE 1/4 Section Number 10 Township Number T 11 S Range Number R 32 ~~36W~~
 County: Logan

Distance and direction from nearest town or city street address of well if located within city?

2 WATER WELL OWNER: Eric Kohn/One Stop-Steve Moore/Agro-Petro, Inc.
 RR#, St. Address, Box #: Hwy 40 & Smokey Hill Rd Board of Agriculture, Division of Water Resources
 City, State, ZIP Code: Oakley, KS 67748 Application Number:

3 LOCATE WELL'S LOCATION WITH AN "X" IN SECTION BOX: DEPTH OF COMPLETED WELL: 135 ft. ELEVATION: RLM 3054.85 TOL 3054.49

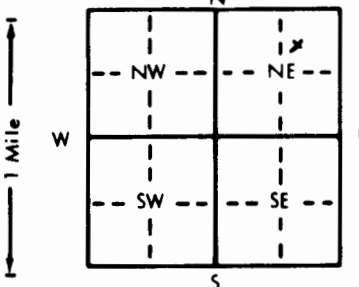

Depth(s) Groundwater Encountered 1. 120 ft. 2. ft. 3. ft.
 WELL'S STATIC WATER LEVEL ~~2953.85~~ 114.4 ft. below land surface measured on mo/day/yr 10-2-95
 Pump test data: Well water was ft. after hours pumping gpm
 Est. Yield gpm: Well water was ft. after hours pumping gpm
 Bore Hole Diameter 8.5 in. to 134 ft. and 2 in. to 136 ft.
 WELL WATER TO BE USED AS: 5 Public water supply 8 Air conditioning 11 Injection well
 1 Domestic 3 Feedlot 6 Oil field water supply 9 Dewatering 12 Other (Specify below)
 2 Irrigation 4 Industrial 7 Lawn and garden only Monitoring well MW14
 Was a chemical/bacteriological sample submitted to Department? Yes No X; If yes, mo/day/yr sample was submitted
 Water Well Disinfected? Yes No X

5 TYPE OF BLANK CASING USED: 5 Wrought iron 8 Concrete tile CASING JOINTS: Glued Clamped
 1 Steel 3 RMP (SR) 6 Asbestos-Cement 9 Other (specify below) Welded
 PVC 4 ABS 7 Fiberglass Threaded 4TPI
 Blank casing diameter 3.998 in. to 4.5000 ft. Dia. in. to ft. Dia. in. to ft.
 Casing height above land surface in. weight 2.07 lbs./ft. Wall thickness or gauge No. 237

TYPE OF SCREEN OR PERFORATION MATERIAL: PVC 10 Asbestos-cement
 1 Steel 3 Stainless steel 5 Fiberglass 8 RMP (SR) 11 Other (specify)
 2 Brass 4 Galvanized steel 6 Concrete tile 9 ABS 12 None used (open hole)

SCREEN OR PERFORATION OPENINGS ARE: 5 Gauzed wrapped 8 Saw cut 11 None (open hole)
 1 Continuous slot Mill slot 6 Wire wrapped 9 Drilled holes
 2 Louvered shutter 4 Key punched 104 7 Torch cut 134 10 Other (specify)

SCREEN-PERFORATED INTERVALS: From 2919.85 ft. to 2949.85 ft. From ft. to ft.
 From ft. to ft. From ft. to ft.
 GRAVEL PACK INTERVALS: From 2919.85 ft. to 2953.85 ft. From ft. to ft.
 From 100 ft. to 136 ft. From ft. to ft.

6 GROUT MATERIAL: Neat cement 2 Cement grout Bentonite 4 Other
 Grout Intervals: From 2953.85 ft. to 3051.85 ft. From ft. to ft. From ft. to ft.

What is the nearest source of possible contamination:
 1 Septic tank 4 Lateral lines 7 Pit privy 10 Livestock pens 14 Abandoned water well
 2 Sewer lines 5 Cess pool 8 Sewage lagoon Fuel storage 15 Oil well/Gas well
 3 Watertight sewer lines 6 Seepage pit 9 Feedyard 12 Fertilizer storage 16 Other (specify below)
 13 Insecticide storage

Direction from well? How many feet?

FROM	TO	LITHOLOGIC LOG	FROM	TO	PLUGGING INTERVALS
0	60	Clayey Silt			
60	70	Clayey Sand			
70	80	Silty Clay			
80	81	Sand			
81	100	Clay			
100	110	Silty Sandy Clay			
110	120	Sand			
120	134	Silty Clay			
134	136	Sand			

7 CONTRACTOR'S OR LANDOWNER'S CERTIFICATION: This water well was (1) constructed (2) reconstructed, or (3) plugged under my jurisdiction and was completed on (mo/day/year) 9-10-95 and this record is true to the best of my knowledge and belief. Kansas Water Well Contractor's License No. 594 This Water Well Record was completed on (mo/day/yr) 10-9-95 under the business name of Coranco, Inc. by (signature) [Signature]