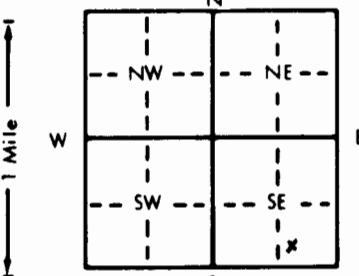


OWZ

1 LOCATION OF WATER WELL: Fraction SE 1/4 SE 1/4 SE 1/4 Section Number 3 Township Number T 11 S Range Number R 32
 County: Logan Distance and direction from nearest town or city street address of well if located within city?

2 WATER WELL OWNER: Eric Kohm/One Stop-Steve Moore/Agro-Petro, Inc.
 RR#, St. Address, Box # : Hwy 40& Smokey Hill Rd Board of Agriculture, Division of Water Resources
 City, State, ZIP Code : Oakley, KS 67748 Application Number:

3 LOCATE WELL'S LOCATION WITH AN "X" IN SECTION BOX:

 4 DEPTH OF COMPLETED WELL: 135 ft. ELEVATION: RIM 3056.57 TOL 3056.19
 Depth(s) Groundwater Encountered 1. 120 ft. 2. ft. 3. ft.
 WELL'S STATIC WATER LEVEL N/A ft. below land surface measured on mo/day/yr
 Pump test data: Well water was ft. after hours pumping gpm
 Est. Yield gpm: Well water was ft. after hours pumping gpm
 Bore Hole Diameter 8.5 in. to 133 ft., and 2 in. to 135 ft.
 WELL WATER TO BE USED AS: 5 Public water supply 8 Air conditioning 11 Injection well
 1 Domestic 3 Feedlot 6 Oil field water supply 9 Dewatering 12 Other (Specify below)
 2 Irrigation 4 Industrial 7 Lawn and garden only ~~10~~ Monitoring well OWZ
 Was a chemical/bacteriological sample submitted to Department? Yes.....No........; If yes, mo/day/yr sample was submitted
 Water Well Disinfected? Yes No

5 TYPE OF BLANK CASING USED: 5 Wrought iron 8 Concrete tile CASING JOINTS: Glued Clamped
 1 Steel 3 RMP (SR) 6 Asbestos-Cement 9 Other (specify below) Welded
 PVC 4 ABS 7 Fiberglass Threaded 4TPI
 Blank casing diameter 3.998 in. to 4.500 ft., Dia. in. to ft., Dia. in. to ft.
 Casing height above land surface. in., weight lbs./ft. Wall thickness or gauge No.
 TYPE OF SCREEN OR PERFORATION MATERIAL: PVC 10 Asbestos-cement
 1 Steel 3 Stainless steel 5 Fiberglass 8 RMP (SR) 11 Other (specify)
 2 Brass 4 Galvanized steel 6 Concrete tile 9 ABS 12 None used (open hole)
 SCREEN OR PERFORATION OPENINGS ARE: 5 Gauzed wrapped 8 Saw cut 11 None (open hole)
 1 Continuous slot Mill slot 6 Wire wrapped 9 Drilled holes
 2 Louvered shutter 4 Key punched 7 Torch cut 10 Other (specify)
 SCREEN-PERFORATED INTERVALS: From 2921.95 ft. to 2921.95 ft., From ft. to ft.
 From ft. to ft., From ft. to ft.
 GRAVEL PACK INTERVALS: From 2921.95 ft. to 2937.95 ft., From ft. to ft.
 From 124 ft. to 137 ft., From ft. to ft.

6 GROUT MATERIAL: Neat cement 2 Cement grout Bentonite 4 Other
 Grout intervals: From 2921.95 ft. to 3053.57 ft., From ft. to ft., From ft. to ft.
 What is the nearest source of possible contamination:
 1 Septic tank 4 Lateral lines 7 Pit privy 10 Livestock pens 14 Abandoned water well
 2 Sewer lines 5 Cess pool 8 Sewage lagoon 11 Fuel storage 15 Oil well/Gas well
 3 Watertight sewer lines 6 Seepage pit 9 Feedyard 12 Fertilizer storage 16 Other (specify below)
 13 Insecticide storage
 Direction from well? How many feet?

FROM	TO	LITHOLOGIC LOG	FROM	TO	PLUGGING INTERVALS
0	45	Silt			
45	50	Clay			
50	60	Clayey Sand			
60	70	Clay			
70	100	Sand			
100	130	Clay			
130	135	Sand			
135	135	Clay			

7 CONTRACTOR'S OR LANDOWNER'S CERTIFICATION: This water well was (1) constructed, (2) reconstructed, or (3) plugged under my jurisdiction and was completed on (mo/day/year) 8-28-95 and this record is true to the best of my knowledge and belief. Kansas Water Well Contractor's License No. 594 This Water Well Record was completed on (mo/day/year) 10-9-95 under the business name of Coranco, Inc. by (signature) [Signature]

OFFICE USE ONLY
T
R
EW
SEC.
1/4
1/4
1/4