

1 LOCATION OF WATER WELL:	Fraction	Section Number	Township Number	Range Number
County: <b>LOGAN</b>	<b>SE 1/4 SE 1/4 SE 1/4</b>	<b>3</b>	<b>T 11 S</b>	<b>R 32</b>

Distance and direction from nearest town or city street address of well if located within city?

2 WATER WELL OWNER: **Eric Kohn/One Stop-Steve Moore/Agro-Petro, Inc.**RR#, St. Address, Box # : **Hwy 40 & Smokey Hill Rd**

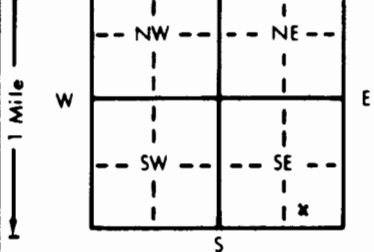
Board of Agriculture, Division of Water Resources

City, State, ZIP Code : **Oakley, KS 67748**

Application Number:

3 LOCATE WELL'S LOCATION WITH AN "X" IN SECTION BOX: 4 DEPTH OF COMPLETED WELL: **85** ft. ELEVATION: **RIM 3056.78 TOL 3056.39**

AN "X" IN SECTION BOX:

Depth(s) Groundwater Encountered 1. **N/A** ft. 2. ft. 3. ft.WELL'S STATIC WATER LEVEL **N/A** ft. below land surface measured on mo/day/yr

Pump test data: Well water was ft. after hours pumping gpm

Est. Yield gpm: Well water was ft. after hours pumping gpm

Bore Hole Diameter **8.5** in. to **8.4** ft. and **2** in. to **86** ft.

WELL WATER TO BE USED AS: 5 Public water supply 8 Air conditioning 11 Injection well

1 Domestic 3 Feedlot 6 Oil field water supply 9 Dewatering 12 Other (Specify below)

2 Irrigation 4 Industrial 7 Lawn and garden only ☒ Monitoring well **VIEW 1**Was a chemical/bacteriological sample submitted to Department? Yes No ☒ If yes, mo/day/yr sample was submittedWater Well Disinfected? Yes No ☒

5 TYPE OF BLANK CASING USED: 5 Wrought iron 8 Concrete tile CASING JOINTS: Glued Clamped

1 Steel 3 RMP (SR) 6 Asbestos-Cement 9 Other (specify below) Welded

☒ PVC 4 ABS 7 Fiberglass Threaded **4TPI**Blank casing diameter **1.913/2.375** in. to ft., Dia. in. to ft., Dia. in. to ft.

Casing height above land surface in., weight lbs./ft. Wall thickness or gauge No.

TYPE OF SCREEN OR PERFORATION MATERIAL: ☒ PVC 10 Asbestos-cement

1 Steel 3 Stainless steel 5 Fiberglass 8 RMP (SR) 11 Other (specify)

2 Brass 4 Galvanized steel 6 Concrete tile 9 ABS 12 None used (open hole)

SCREEN OR PERFORATION OPENINGS ARE: 5 Gauzed wrapped 8 Saw cut 11 None (open hole)

1 Continuous slot ☒ Mill slot 6 Wire wrapped 9 Drilled holes

2 Louvered shutter 4 Key punched 7 Torch cut 10 Other (specify)

SCREEN-PERFORATED INTERVALS: From **2992.77** ft. to **2997.77** ft. From ft. to ft.From **59** ft. to **85** ft. From ft. to ft.GRAVEL PACK INTERVALS: From **2992.77** ft. to **2997.77** ft. From ft. to ft.

From ft. to ft. From ft. to ft.

6 GROUT MATERIAL: ☒ Neat cement 2 Cement grout ☒ Bentonite 4 OtherGrout intervals: From **2992.77** ft. to **3053.78** ft. From ft. to ft. From ft. to ft.

What is the nearest source of possible contamination: 10 Livestock pens 14 Abandoned water well

1 Septic tank 4 Lateral lines 7 Pit privy ☒ Fuel storage 15 Oil well/Gas well

2 Sewer lines 5 Cess pool 8 Sewage lagoon 12 Fertilizer storage 16 Other (specify below)

3 Watertight sewer lines 6 Seepage pit 9 Feedyard 13 Insecticide storage

Direction from well? How many feet?

FROM	TO	LITHOLOGIC LOG	FROM	TO	PLUGGING INTERVALS
0	9	Fill Sand			
9	25	Silt			
25	34	Clay			
34	39	Silt			
39	44	Clay			
44	45	Silt			
45	69	Clay			
69	84	Sand			
84	86	Clay			

7 CONTRACTOR'S OR LANDOWNER'S CERTIFICATION: This water well was (1) constructed (2) reconstructed, or (3) plugged under my jurisdiction and was

completed on (mo/day/year) **B-28-95** and this record is true to the best of my knowledge and belief. KansasWater Well Contractor's License No. **594** This Water Well Record was completed on (mo/day/yr) **10-9-95**under the business name of **Coranco, Inc.** by (signature) *[Signature]*