


1 LOCATION OF WATER WELL: Fraction **SE 1/4 SE 1/4 SE 1/4** Section Number **3** Township Number **T 11 S** Range Number **R 32**
 County: **Logan**

Distance and direction from nearest town or city street address of well if located within city?

2 WATER WELL OWNER: **Eric Kohn/One Stop-Steve Moore/Agro-Petro, Inc.**
 RR#, St. Address, Box #: **Hwy 40 & Smokey Hill Rd**
 City, State, ZIP Code: **Oakley, KS 67748**
 Board of Agriculture, Division of Water Resources
 Application Number:

3 LOCATE WELL'S LOCATION WITH AN "X" IN SECTION BOX: 4 DEPTH OF COMPLETED WELL: **85** ft. ELEVATION: **RIM 3056.66 TOL 3056.31**

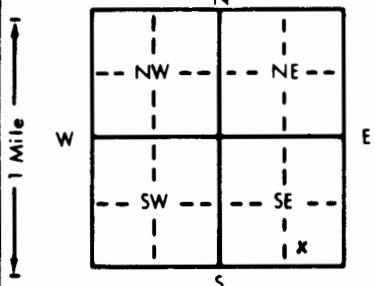

Depth(s) Groundwater Encountered 1. **N/A** ft. 2. ft. 3. ft.
 WELL'S STATIC WATER LEVEL **N/A** ft. below land surface measured on mo/day/yr
 Pump test data: Well water was ft. after hours pumping gpm
 Est. Yield gpm: Well water was ft. after hours pumping gpm
 Bore Hole Diameter **8.5** in. to **84** ft., and **2** in. to **86** ft.
 WELL WATER TO BE USED AS:
 5 Public water supply 8 Air conditioning 11 Injection well
 1 Domestic 3 Feedlot 6 Oil field water supply 9 Dewatering 12 Other (Specify below)
 2 Irrigation 4 Industrial 7 Lawn and garden only Monitoring well **VOBW 1**
 Was a chemical/bacteriological sample submitted to Department? Yes.....No. If yes, mo/day/yr sample was submitted
 Water Well Disinfected? Yes No

5 TYPE OF BLANK CASING USED:
 1 Steel 3 RMP (SR) 5 Wrought iron 8 Concrete tile CASING JOINTS: Glued.....Clamped.....
 PVC 4 ABS 7 Fiberglass 9 Other (specify below) Welded.....
 Blank casing diameter **1.913/2.375** in. to ft., Dia. in. to ft., Dia. in. to ft.
 Casing height above land surface in., weight lbs./ft. Wall thickness or gauge No.

TYPE OF SCREEN OR PERFORATION MATERIAL: PVC 10 Asbestos-cement
 1 Steel 3 Stainless steel 5 Fiberglass 8 RMP (SR) 11 Other (specify).....
 2 Brass 4 Galvanized steel 6 Concrete tile 9 ABS 12 None used (open hole)

SCREEN OR PERFORATION OPENINGS ARE:
 1 Continuous slot Mill slot 5 Gauzed wrapped 8 Saw cut 11 None (open hole)
 2 Louvered shutter 4 Key punched **297.01** 6 Wire wrapped 9 Drilled holes
 SCREEN-PERFORATED INTERVALS: From **297.01** ft. to **297.01** ft., From ft. to ft.
 GRAVEL PACK INTERVALS: From **297.01** ft. to **297.51** ft., From ft. to ft.
 From **58.5** ft. to **85.0** ft., From ft. to ft.

6 GROUT MATERIAL: Neat cement 2 Cement grout Bentonite 4 Other.....
 Grout intervals: From **299.51** ft. to **3053.66** ft., From ft. to ft., From ft. to ft.
 What is the nearest source of possible contamination:
 1 Septic tank 4 Lateral lines 7 Pit privy Fuel storage 14 Abandoned water well
 2 Sewer lines 5 Cess pool 8 Sewage lagoon 12 Fertilizer storage 15 Oil well/Gas well
 3 Watertight sewer lines 6 Seepage pit 9 Feedyard 13 Insecticide storage 16 Other (specify below)

Direction from well? How many feet?

FROM	TO	LITHOLOGIC LOG	FROM	TO	PLUGGING INTERVALS
0	9	Fill Sand			
9	24	Silt			
24	34	Clay			
34	39.0	Silt Silt			
39.0	49.5	Sand Clay			
49.5	50.5	Sand			
50.5	59	Chalk			
59	69.5	Clay			
69.5	84	Sand			
84	86	Clay			

7 CONTRACTOR'S OR LANDOWNER'S CERTIFICATION: This water well was constructed, reconstructed, or plugged under my jurisdiction and was completed on (mo/day/year) **8-27-95** and this record is true to the best of my knowledge and belief. Kansas Water Well Contractor's License No. **594** This Water Well Record was completed on (mo/day/year) **10-19-95** under the business name of **Coranco, Inc.** by (signature) *[Signature]*

OFFICE USE ONLY
T
R
EW
SEC.
1/4
1/4
1/4