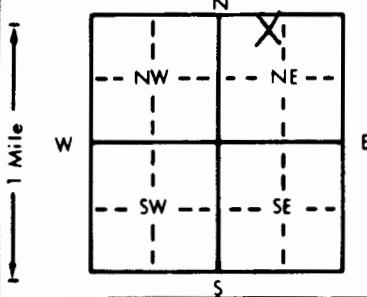


1 LOCATION OF WATER WELL: Fraction Section Number Township Number Range Number  
 County: Logan NE 1/4 NW 1/4 NE 1/4 3 T 11 S R 32 EW

Distance and direction from nearest town or city street address of well if located within city?  
 709 Center

2 WATER WELL OWNER: Country Club Motel  
 RR#, St. Address, Box #: 709 Center Board of Agriculture, Division of Water Resources  
 City, State, ZIP Code: Oakley, Ks. 67748 MW #7 Application Number:

3 LOCATE WELL'S LOCATION WITH AN "X" IN SECTION BOX:  
  
 4 DEPTH OF COMPLETED WELL: 135 ft. ELEVATION:  
 Depth(s) Groundwater Encountered 1. 120.7 ft. 2. ft. 3. ft.  
 WELL'S STATIC WATER LEVEL 120.7 ft. below land surface measured on mo/day/yr  
 Pump test data: Well water was ft. after hours pumping gpm  
 Est. Yield gpm: Well water was ft. after hours pumping gpm  
 Bore Hole Diameter 8 in. to 135 ft. and in. to ft.  
 WELL WATER TO BE USED AS:  
 5 Public water supply 8 Air conditioning 11 Injection well  
 1 Domestic 3 Feedlot 6 Oil field water supply 9 Dewatering 12 Other (Specify below)  
 2 Irrigation 4 Industrial 7 Lawn and garden only 10 Monitoring well  
 Was a chemical/bacteriological sample submitted to Department? Yes No X; If yes, mo/day/yr sample was submitted  
 Water Well Disinfected? Yes No X

5 TYPE OF BLANK CASING USED:  
 1 Steel 3 RMP (SR) 5 Wrought iron 8 Concrete tile CASING JOINTS: Glued Clamped  
 2 PVC 4 ABS 6 Asbestos-Cement 9 Other (specify below) Welded  
 7 Fiberglass Threaded X  
 Blank casing diameter 4 in. to 105 ft. Dia in. to ft. Dia in. to ft.  
 Casing height above land surface 0 in., weight 2.071 lbs./ft. Wall thickness or gauge No. 237  
 TYPE OF SCREEN OR PERFORATION MATERIAL:  
 1 Steel 3 Stainless steel 5 Fiberglass 7 PVC 10 Asbestos-cement  
 2 Brass 4 Galvanized steel 6 Concrete tile 8 RMP (SR) 11 Other (specify)  
 9 ABS 12 None used (open hole)  
 SCREEN OR PERFORATION OPENINGS ARE:  
 1 Continuous slot 3 Mill slot 5 Gauzed wrapped 8 Saw cut 11 None (open hole)  
 2 Louvered shutter 4 Key punched 6 Wire wrapped 9 Drilled holes  
 7 Torch cut 10 Other (specify)  
 SCREEN-PERFORATED INTERVALS: From 105 ft. to 135 ft. From ft. to ft.  
 GRAVEL PACK INTERVALS: From 95 ft. to 135 ft. From ft. to ft.

6 GROUT MATERIAL: 1 Neat cement 2 Cement grout 3 Bentonite 4 Other  
 Grout Intervals: From 0 ft. to 2 ft. From 2 ft. to 95 ft. From ft. to ft.  
 What is the nearest source of possible contamination:  
 1 Septic tank 4 Lateral lines 7 Pit privy 10 Livestock pens 14 Abandoned water well  
 2 Sewer lines 5 Cess pool 8 Sewage lagoon 11 Fuel storage 15 Oil well/Gas well  
 3 Watertight sewer lines 6 Seepage pit 9 Feedyard 12 Fertilizer storage 16 Other (specify below)  
 13 Insecticide storage 13 Insecticide storage Removed Fuel Tank  
 Direction from well? How many feet? Storage

FROM	TO	LITHOLOGIC LOG	FROM	TO	PLUGGING INTERVALS
0	.6	Rocks	90	108	Sandy Clay w/a Few Caliche Strks.
.6	10	Loess			
10	22	Loess	108	135	Med. Sand & Gravel w/a Few Clay Strks.
22	34	Med. Sand & Gravel w/a Few Clay Strks. & Rocks			
34	42	Sandy Clay w/Caliche & a Few Sand Strks.			
42	54	Sandy Clay w/Tight Fine Sand			
54	60	Sandy Clay w/Caliche Strks.			
60	64	Med. Sand & Gravel w/Rocks			
64	70	Sandy Clay w/Clay & Some Med. Sand			
70	78	Med. Sand & Gravel			
78	79	Caliche			
79	90	Sandy Clay w/a Few Caliche St.			

7 CONTRACTOR'S OR LANDOWNER'S CERTIFICATION: This water well was (1) constructed, (2) reconstructed, or (3) plugged under my jurisdiction and was completed on (mo/day/year) 1-22-96 and this record is true to the best of my knowledge and belief. Kansas Water Well Contractor's License No. 554 This Water Well Record was completed on (mo/day/yr) 2-6-96 under the business name of Woofter Pump & Well, Inc. by (signature) Gary L. Woofter