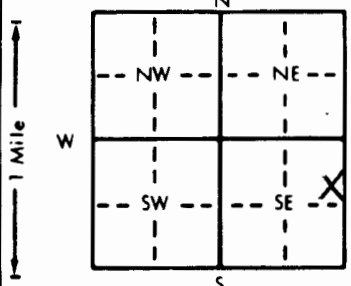


1 LOCATION OF WATER WELL: Fraction SE 1/4 NE 1/4 SE 1/4 Section Number 3 Township Number T 11 S Range Number R 32 EW
 County: Logan

Distance and direction from nearest town or city street address of well if located within city?

2 WATER WELL OWNER: Great Western Tire
 RR#, St. Address, Box # : 319 E. Front Board of Agriculture, Division of Water Resources
 City, State, ZIP Code : Oakley, Ks. 67748 MW # 11 Application Number:

3 LOCATE WELL'S LOCATION WITH AN "X" IN SECTION BOX:

 4 DEPTH OF COMPLETED WELL: 130 ft. ELEVATION:
 Depth(s) Groundwater Encountered 1. ft. 2. ft. 3. ft.
 WELL'S STATIC WATER LEVEL 117.09 ft. below land surface measured on mo/day/yr
 Pump test data: Well water was ft. after hours pumping gpm
 Est. Yield gpm: Well water was ft. after hours pumping gpm
 Bore Hole Diameter: 8 in. to 130 ft., and in. to ft.
 WELL WATER TO BE USED AS: 5 Public water supply 8 Air conditioning 11 Injection well
 1 Domestic 3 Feedlot 6 Oil field water supply 9 Dewatering 12 Other (Specify below)
 2 Irrigation 4 Industrial 7 Lawn and garden only 10 Monitoring well
 Was a chemical/bacteriological sample submitted to Department? Yes.....No...X.....; If yes, mo/day/yr sample was sub-
 mitted Water Well Disinfected? Yes No X

5 TYPE OF BLANK CASING USED: 5 Wrought iron 8 Concrete tile CASING JOINTS: Glued Clamped
 1 Steel 3 RMP (SR) 6 Asbestos-Cement 9 Other (specify below) Welded
 2 PVC 4 ABS 7 Fiberglass Threaded X
 Blank casing diameter 4 in. to 100 ft., Dia in. to ft., Dia in. to ft.
 Casing height above land surface 0 in., weight 2.071 lbs./ft. Wall thickness or gauge No. 237
 TYPE OF SCREEN OR PERFORATION MATERIAL: 7 PVC 10 Asbestos-cement
 1 Steel 3 Stainless steel 5 Fiberglass 8 RMP (SR) 11 Other (specify)
 2 Brass 4 Galvanized steel 6 Concrete tile 9 ABS 12 None used (open hole)
 SCREEN OR PERFORATION OPENINGS ARE: 5 Gauzed wrapped 8 Saw cut 11 None (open hole)
 1 Continuous slot 3 Mill slot 6 Wire wrapped 9 Drilled holes
 2 Louvered shutter 4 Key punched 7 Torch cut 10 Other (specify)
 SCREEN-PERFORATED INTERVALS: From 100 ft. to 130 ft., From ft. to ft.
 From ft. to ft., From ft. to ft.
 GRAVEL PACK INTERVALS: From 98 ft. to 130 ft., From ft. to ft.
 From ft. to ft., From ft. to ft.

6 GROUT MATERIAL: 1 Neat cement 2 Cement grout 3 Bentonite 4 Other
 Grout Intervals: From 0 ft. to 2 ft., From 2 ft. to 98 ft., From ft. to ft.
 What is the nearest source of possible contamination:
 1 Septic tank 4 Lateral lines 7 Pit privy 10 Livestock pens 14 Abandoned water well
 2 Sewer lines 5 Cess pool 8 Sewage lagoon 11 Fuel storage 15 Oil well/Gas well
 3 Watertight sewer lines 6 Seepage pit 9 Feedyard 12 Fertilizer storage 16 Other (specify below)
 13 Insecticide storage Removed Fuel Storage

Direction from well? How many feet?

FROM	TO	LITHOLOGIC LOG	FROM	TO	PLUGGING INTERVALS
0	2	surface	92	108	clay, caliche & sand
2	24	loess	108	124	med sand w/ clay stks
24	33	clay & caliche	124	125	clay
33	35	caliche	125	130	fine med sand w/ caliche stks
35	37	clay			
37	39	sand			
39	43	clay			
43	46	fine sand w/ clay			
46	52	clay, caliche, & fine sand			
52	57	clay w/ caliche			
57	67	fine med sand w/ caliche			
67	76	sandy clay w/ caliche			
76	83	clay & caliche			
83	87	tight sand w/ clay			
87	92	med sand			

7 CONTRACTOR'S OR LANDOWNER'S CERTIFICATION: This water well was (1) constructed, (2) reconstructed, or (3) plugged under my jurisdiction and was completed on (mo/day/year) 8-15-96 and this record is true to the best of my knowledge and belief. Kansas Water Well Contractor's License No. 554 This Water Well Record was completed on (mo/day/yr) 9-12-96 under the business name of Woofter Pump & Well, Inc. by (signature) *[Signature]*

OFFICE USE ONLY
T
R
EW
SEC.
1/4
1/4
1/4