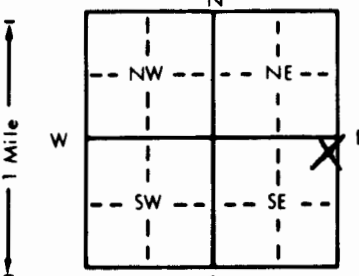


1 LOCATION OF WATER WELL: Fraction NE 1/4 NE 1/4 SE 1/4 Section Number 3 Township Number T 11 S Range Number R 32 E/W  
 County: Logan  
 Distance and direction from nearest town or city street address of well if located within city?

2 WATER WELL OWNER: Great Western Tire  
 RR#, St. Address, Box # : 319 E. Front Board of Agriculture, Division of Water Resources  
 City, State, ZIP Code : Oakley, Ks. 67748 MW #12 Application Number:

3 LOCATE WELL'S LOCATION WITH AN "X" IN SECTION BOX:  
  
 4 DEPTH OF COMPLETED WELL: 130 ft. ELEVATION:  
 Depth(s) Groundwater Encountered 1. 119.10 ft. 2. 130 ft. 3. 130 ft.  
 WELL'S STATIC WATER LEVEL 119.10 ft. below land surface measured on mo/day/yr  
 Pump test data: Well water was \_\_\_\_\_ ft. after \_\_\_\_\_ hours pumping \_\_\_\_\_ gpm  
 Est. Yield \_\_\_\_\_ gpm: Well water was \_\_\_\_\_ ft. after \_\_\_\_\_ hours pumping \_\_\_\_\_ gpm  
 Bore Hole Diameter 8 in. to 130 ft., and \_\_\_\_\_ in. to \_\_\_\_\_ ft.  
 WELL WATER TO BE USED AS: 5 Public water supply 8 Air conditioning 11 Injection well  
 1 Domestic 3 Feedlot 6 Oil field water supply 9 Dewatering 12 Other (Specify below)  
 2 Irrigation 4 Industrial 7 Lawn and garden only 10 Monitoring well  
 Was a chemical/bacteriological sample submitted to Department? Yes \_\_\_\_\_ No X \_\_\_\_\_; If yes, mo/day/yr sample was submitted \_\_\_\_\_  
 Water Well Disinfected? Yes \_\_\_\_\_ No X \_\_\_\_\_

5 TYPE OF BLANK CASING USED:  
 1 Steel 3 RMP (SR) 5 Wrought iron 8 Concrete tile CASING JOINTS: Glued \_\_\_\_\_ Clamped \_\_\_\_\_  
 2 PVC 4 ABS 6 Asbestos-Cement 9 Other (specify below) Welded \_\_\_\_\_  
 7 Fiberglass \_\_\_\_\_ Threaded X \_\_\_\_\_  
 Blank casing diameter 4 in. to 100 ft., Dia. \_\_\_\_\_ in. to \_\_\_\_\_ ft., Dia. \_\_\_\_\_ in. to \_\_\_\_\_ ft.  
 Casing height above land surface 0 in., weight 2.071 lbs./ft. Wall thickness or gauge No. 237  
 TYPE OF SCREEN OR PERFORATION MATERIAL:  
 1 Steel 3 Stainless steel 5 Fiberglass 7 PVC 10 Asbestos-cement  
 2 Brass 4 Galvanized steel 6 Concrete tile 8 RMP (SR) 11 Other (specify) \_\_\_\_\_  
 9 ABS 12 None used (open hole)  
 SCREEN OR PERFORATION OPENINGS ARE:  
 1 Continuous slot 3 Mill slot 5 Gauzed wrapped 8 Saw cut 11 None (open hole)  
 2 Louvered shutter 4 Key punched 6 Wire wrapped 9 Drilled holes  
 7 Torch cut 10 Other (specify) \_\_\_\_\_  
 SCREEN-PERFORATED INTERVALS: From 100 ft. to 130 ft., From \_\_\_\_\_ ft. to \_\_\_\_\_ ft.  
 From 98 ft. to 130 ft., From \_\_\_\_\_ ft. to \_\_\_\_\_ ft.  
 GRAVEL PACK INTERVALS: From \_\_\_\_\_ ft. to \_\_\_\_\_ ft., From \_\_\_\_\_ ft. to \_\_\_\_\_ ft.

6 GROUT MATERIAL: 1 Neat cement 2 Cement grout 3 Bentonite 4 Other \_\_\_\_\_  
 Grout Intervals: From 0 ft. to 2 ft., From 2 ft. to 98 ft., From \_\_\_\_\_ ft. to \_\_\_\_\_ ft.  
 What is the nearest source of possible contamination:  
 1 Septic tank 4 Lateral lines 7 Pit privy 10 Livestock pens 14 Abandoned water well  
 2 Sewer lines 5 Cess pool 8 Sewage lagoon 11 Fuel storage 15 Oil well/Gas well  
 3 Watertight sewer lines 6 Seepage pit 9 Feedyard 12 Fertilizer storage 16 Other (specify below)  
 13 Insecticide storage Removed Fuel Storage  
 Direction from well? \_\_\_\_\_ How many feet? \_\_\_\_\_

| FROM | TO | LITHOLOGIC LOG                       | FROM | TO  | PLUGGING INTERVALS                |
|------|----|--------------------------------------|------|-----|-----------------------------------|
| 0    | 3  | surface                              | 86   | 93  | fine med sand w/ clay             |
| 3    | 17 | loess                                | 93   | 97  | clay & caliche w/ sand stks       |
| 17   | 29 | sandy clay w/ caliche stks           | 97   | 110 | sandy clay w/ caliche & sand stks |
| 29   | 34 | caliche & clay                       |      |     |                                   |
| 34   | 37 | caliche w/ tight sand stks & clay    | 110  | 126 | fine med sand w/ clay stks        |
| 37   | 39 | med sand                             | 126  | 127 | clay                              |
| 39   | 40 | caliche                              | 127  | 130 | fine med sand                     |
| 40   | 47 | fine tight sand w/ clay              |      |     |                                   |
| 47   | 54 | clay w/ sand stks                    |      |     |                                   |
| 54   | 63 | fine med sand w/ clay stks           |      |     |                                   |
| 63   | 64 | caliche                              |      |     |                                   |
| 64   | 72 | fine med sand                        |      |     |                                   |
| 72   | 86 | caliche w/ clay & cemented sand stks |      |     |                                   |

7 CONTRACTOR'S OR LANDOWNER'S CERTIFICATION: This water well was (1) constructed, (2) reconstructed, or (3) plugged under my jurisdiction and was completed on (mo/day/year) 8-15-96 and this record is true to the best of my knowledge and belief. Kansas Water Well Contractor's License No. 554 This Water Well Record was completed on (mo/day/yr) 9-12-96 under the business name of Woofter Pump & Well, Inc. by (signature) Jay C. Woofter

OFFICE USE ONLY  
T  
R  
E/W  
SEC.  
1/4  
1/4  
1/4