


1 LOCATION OF WATER WELL: Fraction NW 1/4 NE 1/4 Section Number 3 Township Number T 11 S Range Number R 32 **EW**
 County: Logan

Distance and direction from nearest town or city street address of well if located within city?

709 Center

2 WATER WELL OWNER: Country Club Motel
 RR#, St. Address, Box #: 709 Center Board of Agriculture, Division of Water Resources
 City, State, ZIP Code: Oakley, Ks. 67748 MW#13 Application Number:

3 LOCATE WELL'S LOCATION WITH AN "X" IN SECTION BOX:

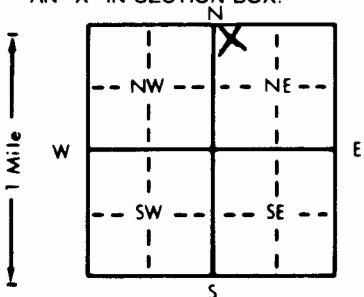

4 DEPTH OF COMPLETED WELL: 135 ft. ELEVATION:
 Depth(s) Groundwater Encountered 1 ft. 2 ft. 3 ft.
 WELL'S STATIC WATER LEVEL: 122.21 ft. below land surface measured on mo/day/yr
 Pump test data: Well water was ft. after hours pumping gpm
 Est. Yield gpm: Well water was ft. after hours pumping gpm
 Bore Hole Diameter: 8 in. to 135 ft. and in. to ft.
 WELL WATER TO BE USED AS: 5 Public water supply 8 Air conditioning 11 Injection well
 1 Domestic 3 Feedlot 6 Oil field water supply 9 Dewatering 12 Other (Specify below)
 2 Irrigation 4 Industrial 7 Lawn and garden only 10 Monitoring well
 Was a chemical/bacteriological sample submitted to Department? Yes No **X**; If yes, mo/day/yr sample was submitted
 Water Well Disinfected? Yes No **X**

5 TYPE OF BLANK CASING USED:
 1 Steel 3 RMP (SR) 5 Wrought iron 8 Concrete tile CASING JOINTS: Glued Clamped
 2 PVC 4 ABS 6 Asbestos-Cement 9 Other (specify below) Welded
 7 Fiberglass Threaded **X**
 Blank casing diameter: 4 in. to 105 ft., Dia. in. to ft., Dia. in. to ft.
 Casing height above land surface: 0 in., weight: 2.071 lbs./ft. Wall thickness or gauge No.: 237

TYPE OF SCREEN OR PERFORATION MATERIAL:
 1 Steel 3 Stainless steel 5 Fiberglass 7 PVC 10 Asbestos-cement
 2 Brass 4 Galvanized steel 6 Concrete tile 8 RMP (SR) 11 Other (specify)
 9 ABS 12 None used (open hole)
 SCREEN OR PERFORATION OPENINGS ARE:
 1 Continuous slot 3 Mill slot 5 Gauzed wrapped 8 Saw cut 11 None (open hole)
 2 Louvered shutter 4 Key punched 6 Wire wrapped 9 Drilled holes
 7 Torch cut 10 Other (specify)
 SCREEN-PERFORATED INTERVALS: From 105 ft. to 135 ft., From ft. to ft.
 From ft. to ft., From ft. to ft.
 GRAVEL PACK INTERVALS: From 102 ft. to 135 ft., From ft. to ft.
 From ft. to ft., From ft. to ft.

6 GROUT MATERIAL: 1 Neat cement 2 Cement grout 3 Bentonite 4 Other
 Grout Intervals: From 0 ft. to 2 ft., From 2 ft. to 102 ft., From ft. to ft.
 What is the nearest source of possible contamination:
 1 Septic tank 4 Lateral lines 7 Pit privy 10 Livestock pens 14 Abandoned water well
 2 Sewer lines 5 Cess pool 8 Sewage lagoon 11 Fuel storage 15 Oil well/Gas well
 3 Watertight sewer lines 6 Seepage pit 9 Feedyard 12 Fertilizer storage 16 Other (specify below)
 13 Insecticide storage **Removed Fuel Storage**

Direction from well?		LITHOLOGIC LOG		PLUGGING INTERVALS	
FROM	TO	FROM	TO	FROM	TO
0	2	Surface			
2	20	Loess			
20	26	Sandy Clay w/Sand Strks.			
26	38	Tight Med. Sand w/Clay			
38	60	Sandy Clay w/Caliche & Some Sand			
60	64	Med. Sand & Gravel			
64	67	Sandy Clay			
67	83	Med. Sand & Gravel w/Caliche Strks.			
83	90	Cemented Sand w/Sand & Clay Strks.			
90	110	Sandy Clay & Caliche w/a Few Sand Strks.			
110	135	Med. Sand & Gravel w/Some Clay & Cemented Sand			

7 CONTRACTOR'S OR LANDOWNER'S CERTIFICATION: This water well was (1) constructed, (2) reconstructed, or (3) plugged under my jurisdiction and was completed on (mo/day/year) 11-21-96 and this record is true to the best of my knowledge and belief. Kansas Water Well Contractor's License No. 554 This Water Well Record was completed on (mo/day/yr) 11-26-96 under the business name of Woofter Pump & Well, Inc. by (signature)

OFFICE USE ONLY
T
R
EM
SEC.
1/4
1/4
1/4