


VIEW-1

1 LOCATION OF WATER WELL: Fraction NW 1/4 NW 1/4 SW 1/4 Section Number 3 Township Number T 11 S Range Number R 32 EW

Distance and direction from nearest town or city street address of well if located within city?  
411 W. Second Street, Oakley, Kansas

2 WATER WELL OWNER: Co-Ag Coop  
RR#, St. Address, Box # : 1195 Albert St. Board of Agriculture, Division of Water Resources  
City, State, ZIP Code : Oakley, Kansas, 67448 Application Number:

3 LOCATE WELL'S LOCATION WITH AN "X" IN SECTION BOX:  
4 DEPTH OF COMPLETED WELL: 100' ft. ELEVATION: 3048.19 FT  
Depth(s) Groundwater Encountered 1. Not Reached ft. 2. ft. 3. ft.  
WELL'S STATIC WATER LEVEL NA ft. below land surface measured on mo/day/yr  
Pump test data: Well water was ft. after hours pumping gpm  
Est. Yield gpm: Well water was ft. after hours pumping gpm  
Bore Hole Diameter 8 in. to 100' ft., and in. to ft.  
WELL WATER TO BE USED AS: 5 Public water supply 8 Air conditioning 11 Injection well  
1 Domestic 3 Feedlot 6 Oil field water supply 9 Dewatering 12 Other (Specify below)  
2 Irrigation 4 Industrial 7 Lawn and garden only 10 Monitoring well  
Was a chemical/bacteriological sample submitted to Department? Yes No; If yes, mo/day/yr sample was submitted  
Water Well Disinfected? Yes No

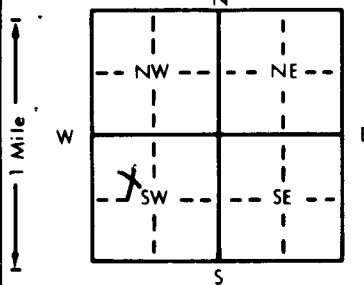

5 TYPE OF BLANK CASING USED:  
1 Steel 3 RMP (SR) 5 Wrought iron 8 Concrete tile CASING JOINTS: Glued Clamped  
2 PVC 4 ABS 6 Asbestos-Cement 9 Other (specify below) Welded  
7 Fiberglass Threaded  
Blank casing diameter 4 in. to 80 ft., Dia in. to ft., Dia in. to ft.  
Casing height above land surface in., weight lbs./ft. Wall thickness or gauge No.  
TYPE OF SCREEN OR PERFORATION MATERIAL:  
1 Steel 3 Stainless steel 5 Fiberglass 8 RMP (SR) 10 Asbestos-cement  
2 Brass 4 Galvanized steel 6 Concrete tile 9 ABS 11 Other (specify)  
12 None used (open hole)  
SCREEN OR PERFORATION OPENINGS ARE:  
1 Continuous slot 3 Mill slot 5 Gauzed wrapped 8 Saw cut 11 None (open hole)  
2 Louvered shutter 4 Key punched 6 Wire wrapped 9 Drilled holes  
7 Torch cut 10 Other (specify)  
SCREEN-PERFORATED INTERVALS: From 80 ft. to 100 ft., From ft. to ft.  
GRAVEL PACK INTERVALS: From 78 ft. to 100 ft., From ft. to ft.

6 GROUT MATERIAL: Neat cement 2 Cement grout 3 Bentonite 4 Other Bentonite 76-78  
Grout Intervals: From 76 ft. to 0 ft., From ft. to ft., From ft. to ft.  
What is the nearest source of possible contamination:  
1 Septic tank 4 Lateral lines 7 Pit privy 10 Livestock pens 14 Abandoned water well  
2 Sewer lines 5 Cess pool 8 Sewage lagoon 11 Fuel storage 15 Oil well/Gas well  
3 Watertight sewer lines 6 Seepage pit 9 Feedyard 12 Fertilizer storage 16 Other (specify below)  
13 Insecticide storage

Direction from well? How many feet?

FROM	TO	LITHOLOGIC LOG	FROM	TO	PLUGGING INTERVALS
0	20	Silt; Brown			
20	30	Silt; Brown & Clay; Reddish-Br			
30	35	Sand & Gravel; Brown			
35	40	Clay; Reddish-brown			
40	70	Sand & Gravel; Brown			
70	80	Clay; Reddish-Brown			
80	85	Sand & Gravel; Brown			

7 CONTRACTOR'S OR LANDOWNER'S CERTIFICATION: This water well was (1) constructed, (2) reconstructed, or (3) plugged under my jurisdiction and was completed on (mo/day/year) 9-10-98 and this record is true to the best of my knowledge and belief. Kansas Water Well Contractor's License No. 554 This Water Well Record was completed on (mo/day/yr) 10-20-98 under the business name of Jay Wooley by (signature) [Signature]

OFFICE USE ONLY  
T 119  
R 32  
EW  
SEC. 3  
1/4  
5  
1/4  
1/4