


1 LOCATION OF WATER WELL: County: Logan Fraction: NW 1/4 SW 1/4 NW 1/4 Section Number: 2 Township Number: T 11 S Range Number: R 32 EW

2 WATER WELL OWNER: Oakley Power Plant 400 Price RR#, St. Address, Box #: Oakley, KS 67748 Board of Agriculture, Division of Water Resources Application Number: MW# 10

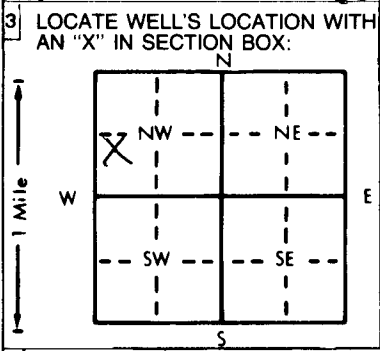

3 LOCATE WELL'S LOCATION WITH AN 'X' IN SECTION BOX: 4 DEPTH OF COMPLETED WELL: 140 ft. ELEVATION: 128 ft. below land surface measured on mo/day/yr

5 TYPE OF BLANK CASING USED: 1 Steel, 2 PVC, 3 RMP (SR), 4 ABS, 5 Wrought iron, 6 Asbestos-Cement, 7 Fiberglass, 8 Concrete tile, 9 Other (specify below), 10 Asbestos-cement, 11 Injection well, 12 Other (Specify below)

6 GROUT MATERIAL: 1 Neat cement, 2 Cement grout, 3 Bentonite, 4 Other. Grout Intervals: From 0 ft. to 103 ft., From 103 ft. to 108 ft.

Table with columns: FROM, TO, LITHOLOGIC LOG, FROM, TO, PLUGGING INTERVALS. Rows describe geological layers from 0 to 140 feet depth.

7 CONTRACTOR'S OR LANDOWNER'S CERTIFICATION: This water well was (1) constructed, (2) reconstructed, or (3) plugged under my jurisdiction and was completed on (mo/day/year) 5-19-97 and this record is true to the best of my knowledge and belief. Kansas Water Well Contractor's License No. 554 This Water Well Record was completed on (mo/day/yr) 6-10-97 under the business name of Woofter Pump & Well, Inc. by (signature) Jay G. Woofter