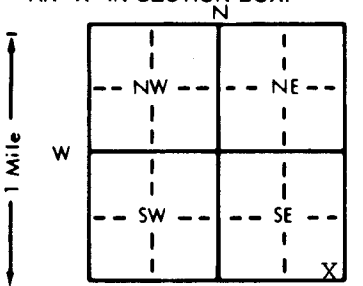


1 LOCATION OF WATER WELL: County: <u>Logan</u>	Fraction <u>SE 1/4</u> <u>SE 1/4</u> <u>SE 1/4</u>	Section Number <u>3</u>	Township Number T <u>11</u> S	Range Number R <u>32</u> E/W
---	---	----------------------------	----------------------------------	---------------------------------

Distance and direction from nearest town or city street address of well if located within city?  
U.S. Highway 40 & Smokey Hill Road Oakley, KS 67748

2 WATER WELL OWNER: Eric Kohn  
 RR#, St. Address, Box # : Hwy 40 & Smokey Hill Road  
 City, State, ZIP Code : Oakley, KS 67748  
 Board of Agriculture, Division of Water Resources  
 Application Number:

3 LOCATE WELL'S LOCATION WITH AN "X" IN SECTION BOX: 	4 DEPTH OF COMPLETED WELL... <u>115'</u> ft. ELEVATION: <u>3054.57</u> T.O.C. Depth(s) Groundwater Encountered 1. .... ft. 2. .... ft. 3. .... ft. WELL'S STATIC WATER LEVEL ... <u>NA</u> ft. below land surface measured on mo/day/yr Pump test data: Well water was .... ft. after .... hours pumping .... gpm Est. Yield .... gpm: Well water was .... ft. after .... hours pumping .... gpm Bore Hole Diameter ... <u>6</u> in. to ... <u>115</u> ft., and, .... in. to .... ft. WELL WATER TO BE USED AS: 1 Domestic    3 Feedlot    6 Oil field water supply    9 Dewatering    12 Other (Specify below) 2 Irrigation    4 Industrial    7 Lawn and garden only    10 Monitoring well <u>Air SPARGLE</u> Was a chemical/bacteriological sample submitted to Department? Yes.....No... <u>X</u> .....; If yes, mo/day/yr sample was sub- mitted Water Well Disinfected? Yes    No <u>X</u>
--	---

5 TYPE OF BLANK CASING USED:  
 1 Steel    3 RMP (SR)    5 Wrought iron    8 Concrete tile    CASING JOINTS: Glued ..... Clamped .....  
 2 PVC    4 ABS    6 Asbestos-Cement    9 Other (specify below)    Welded .....  
 Blank casing diameter ... 2 in. to ..... ft., Dia ..... in. to ..... ft., Dia ..... in. to ..... ft.  
 Casing height above land surface ... 36 in., weight ..... lbs./ft. Wall thickness or gauge No. ....  
 TYPE OF SCREEN OR PERFORATION MATERIAL:  
 1 Steel    3 Stainless steel    5 Fiberglass    7 PVC    10 Asbestos-cement  
 2 Brass    4 Galvanized steel    6 Concrete tile    8 RMP (SR)    11 Other (specify) .....  
 12 None used (open hole)  
 SCREEN OR PERFORATION OPENINGS ARE:  
 1 Continuous slot    3 Mill slot    5 Gauzed wrapped    8 Saw cut    11 None (open hole)  
 2 Louvered shutter    4 Key punched    6 Wire wrapped    9 Drilled holes  
 7 Torch cut    10 Other (specify) .....  
 SCREEN-PERFORATED INTERVALS: From ... 105 ft. to ... 115 ft., From ..... ft. to ..... ft.  
 From ..... ft. to ..... ft., From ..... ft. to ..... ft.  
 GRAVEL PACK INTERVALS: From ..... ft. to ..... ft., From ..... ft. to ..... ft.  
 From ..... ft. to ..... ft., From ..... ft. to ..... ft.

6 GROUT MATERIAL: 1 Neat cement    2 Cement grout    3 Bentonite    4 Other .....  
 Grout Intervals: From ... 103 ft. to 3 ft., From ..... ft. to ..... ft., From ..... ft. to ..... ft.  
 What is the nearest source of possible contamination:  
 1 Septic tank    4 Lateral lines    7 Pit privy    10 Livestock pens    14 Abandoned water well  
 2 Sewer lines    5 Cess pool    8 Sewage lagoon    11 Fuel storage    15 Oil well/Gas well  
 3 Watertight sewer lines    6 Seepage pit    9 Feedyard    12 Fertilizer storage    16 Other (specify below)  
 13 Insecticide storage  
 Direction from well?    How many feet?

FROM	TO	LITHOLOGIC LOG	FROM	TO	PLUGGING INTERVALS
0	55	SILTY CLAY			
55	62	SAND GRAVEL			
62	95	SILTY CLAY			
95	115	SAND GRAVEL			
					SVE-3

7 CONTRACTOR'S OR LANDOWNER'S CERTIFICATION: This water well was (1) constructed, (2) reconstructed, or (3) plugged under my jurisdiction and was completed on (mo/day/year) ..... and this record is true to the best of my knowledge and belief. Kansas Water Well Contractor's License No. 590 This Water Well Record was completed on (mo/day/yr) ..... under the business name of ..... by (signature) Wesley G. Deeks

INSTRUCTIONS: Use typewriter or ball point pen. PLEASE PRESS FIRMLY and PRINT clearly. Please fill in blanks, underline or circle the correct answers. Send top three copies to Kansas Department of Health and Environment, Bureau of Water, Topeka, Kansas 66620-0001. Telephone: 913-296-5545. Send one to WATER WELL OWNER and retain one for your records.