


1 LOCATION OF WATER WELL: County: Logan Fraction: NE 1/4 NE 1/4 NE 1/4 Section Number: 10 Township Number: T 11 S Range Number: R 32 EW

Distance and direction from nearest town or city street address of well if located within city?  
U.S. Hwy 83 & U.S. Hwy 40 Oakley, KS 67748

2 WATER WELL OWNER: Eric Kohn  
 RR#, St. Address, Box #: U.S. Hwy 40 & Smokey Hill Road Board of Agriculture, Division of Water Resources  
 City, State, ZIP Code: Oakley, KS 67748 Application Number:

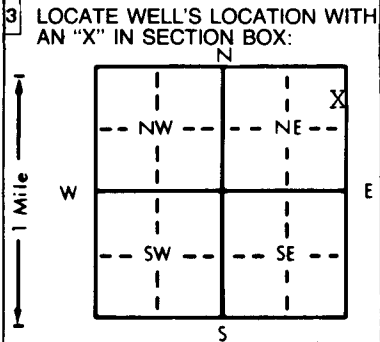

4 DEPTH OF COMPLETED WELL: 135.5 ft. ELEVATION: 3053.00 T.O.C.  
 Depth(s) Groundwater Encountered 1. .... ft. 2. .... ft. 3. .... ft.  
 WELL'S STATIC WATER LEVEL: NA ft. below land surface measured on mo/day/yr  
 Pump test data: Well water was ..... ft. after ..... hours pumping ..... gpm  
 Est. Yield ..... gpm: Well water was ..... ft. after ..... hours pumping ..... gpm  
 Bore Hole Diameter: 8 in. to 135.5 ft., and ..... in. to ..... ft.  
 WELL WATER TO BE USED AS:  
 5 Public water supply 8 Air conditioning 11 Injection well  
 1 Domestic 3 Feedlot 6 Oil field water supply 9 Dewatering 12 Other (Specify below)  
 2 Irrigation 4 Industrial 7 Lawn and garden only 10 Monitoring well  
 Was a chemical/bacteriological sample submitted to Department? Yes.....No...X.....; If yes, mo/day/yr sample was submitted  
 Water Well Disinfected? Yes No X

5 TYPE OF BLANK CASING USED:  
 1 Steel 3 RMP (SR) 5 Wrought iron 8 Concrete tile CASING JOINTS: Glued ..... Clamped .....  
2 PVC 4 ABS 7 Fiberglass ..... Welded .....  
 Blank casing diameter: 0 in. to ..... ft., Dia. .... in. to ..... ft., Dia. .... in. to ..... ft.  
 Casing height above land surface: -6 in., weight ..... lbs./ft. Wall thickness or gauge No. SCH 40 PVC  
 TYPE OF SCREEN OR PERFORATION MATERIAL:  
 1 Steel 3 Stainless steel 5 Fiberglass 7 PVC 10 Asbestos-cement  
 2 Brass 4 Galvanized steel 6 Concrete tile 9 ABS 11 Other (specify) .....  
 12 None used (open hole)  
 SCREEN OR PERFORATION OPENINGS ARE:  
 1 Continuous slot 3 Mill slot 5 Gauzed wrapped 8 Saw cut 11 None (open hole)  
 2 Louvered shutter 4 Key punched 6 Wire wrapped 9 Drilled holes  
 7 Torch cut 10 Other (specify) .....  
 SCREEN-PERFORATED INTERVALS: From 105 ft. to 135 ft., From ..... ft. to ..... ft.  
 GRAVEL PACK INTERVALS: From ..... ft. to ..... ft., From ..... ft. to ..... ft.

6 GROUT MATERIAL: 103 1 Neat cement 2 Cement grout 3 Bentonite 4 Other .....  
 Grout Intervals: From 103 ft. to 6 ft., From ..... ft. to ..... ft., From ..... ft. to ..... ft.  
 What is the nearest source of possible contamination:  
 1 Septic tank 4 Lateral lines 7 Pit privy 11 Fuel storage 14 Abandoned water well  
 2 Sewer lines 5 Cess pool 8 Sewage lagoon 12 Fertilizer storage 15 Oil well/Gas well  
 3 Watertight sewer lines 6 Seepage pit 9 Feedyard 13 Insecticide storage 16 Other (specify below)  
 Direction from well? Northwest How many feet? 400

FROM	TO	LITHOLOGIC LOG	FROM	TO	PLUGGING INTERVALS
0	10	SILT			
10	20	TRACE CALCIUM			
20	25	MOIST FIRM			
25	30	LEAN CLAY			
30	35	SILTY CLAY			
35	40	LEAN CLAY			
40	45	REDDISH BROWN SILT			
45	50	SILTY SAND			MW-17
50	60	REDDISH BROWN TO GRAY SILT			
60	70	MEDIUM DENSE			
70	80	DARK REDDISH BROWN			
80	90	SAND			
90	100	LEAN CLAY			
100	110	SAND			
110	140	REDDISH BROWN SILT			

7 CONTRACTOR'S OR LANDOWNER'S CERTIFICATION: This water well was (1) constructed, (2) reconstructed, or (3) plugged under my jurisdiction and was completed on (mo/day/year) ..... and this record is true to the best of my knowledge and belief. Kansas Water Well Contractor's License No. 590 This Water Well Record was completed on (mo/day/yr) ..... under the business name of ..... by (signature) Wesley H. Fields

INSTRUCTIONS: Use typewriter or ball point pen. PLEASE PRESS FIRMLY and PRINT clearly. Please fill in blanks, underline or circle the correct answers. Send top three copies to Kansas Department of Health and Environment, Bureau of Water, Topeka, Kansas 66620-0001. Telephone: 913-296-5545. Send one to WATER WELL OWNER and retain one for your records.