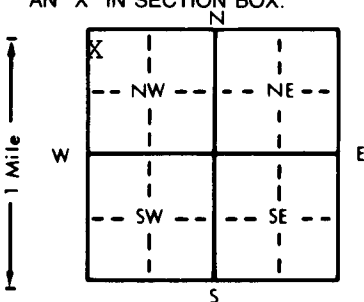


1 LOCATION OF WATER WELL: County: Logan Fraction NW 1/4 NW 1/4 NW 1/4 Section Number 11 Township Number T 11 S Range Number R 32 EW

Distance and direction from nearest town or city street address of well if located within city?
U.S. Hwy 83 & U.S. Hwy 40 Oakley, KS 67748

2 WATER WELL OWNER: Eric Kohn
RR#, St. Address, Box # : Hwy 40 & Smokey Hill Road Board of Agriculture, Division of Water Resources
City, State, ZIP Code : Oakley, KS 67748 Application Number:

3 LOCATE WELL'S LOCATION WITH AN "X" IN SECTION BOX:


4 DEPTH OF COMPLETED WELL: 135.5 ft. ELEVATION: 3053.55 T.O.C.
 Depth(s) Groundwater Encountered 1. ft. 2. ft. 3. ft.
 WELL'S STATIC WATER LEVEL . . . NA ft. below land surface measured on mo/day/yr
 Pump test data: Well water was ft. after hours pumping gpm
 Est. Yield gpm: Well water was ft. after hours pumping gpm
 Bore Hole Diameter. . . . 8 in. to 135.5 ft., and in. to ft.
 WELL WATER TO BE USED AS:
 1 Domestic 3 Feedlot 6 Oil field water supply 9 Dewatering 12 Other (Specify below)
 2 Irrigation 4 Industrial 7 Lawn and garden only 10 Monitoring well
 Was a chemical/bacteriological sample submitted to Department? Yes. No. X; If yes, mo/day/yr sample was submitted
 Water Well Disinfected? Yes No X

5 TYPE OF BLANK CASING USED:
 1 Steel 3 RMP (SR) 5 Wrought iron 8 Concrete tile CASING JOINTS: Glued Clamped
 2 PVC 4 ABS 7 Fiberglass Threaded
 Blank casing diameter . . . 2 in. to ft., Dia in. to ft., Dia in. to ft.
 Casing height above land surface . . . -6 in., weight lbs./ft. Wall thickness or gauge No. SCH 40 PVC
 TYPE OF SCREEN OR PERFORATION MATERIAL:
 1 Steel 2 Stainless steel 5 Fiberglass 7 PVC 10 Asbestos-cement
 2 Brass 4 Galvanized steel 6 Concrete tile 9 ABS 12 None used (open hole)
 SCREEN OR PERFORATION OPENINGS ARE:
 1 Continuous slot 2 Mill slot 3 Gauzed wrapped 8 Saw cut 11 None (open hole)
 2 Louvered shutter 4 Key punched 6 Wire wrapped 9 Drilled holes
 7 Torch cut 10 Other (specify)
 SCREEN-PERFORATED INTERVALS: From . . 105 ft. to . . 135.5 ft., From ft. to ft.
 GRAVEL PACK INTERVALS: From ft. to ft., From ft. to ft.

6 GROUT MATERIAL: 1 Neat cement 2 Cement grout 3 Bentonite 4 Other
 Grout Intervals: From . . 103 ft. to . . 3 ft., From ft. to ft., From ft. to ft.
 What is the nearest source of possible contamination:
 1 Septic tank 4 Lateral lines 7 Pit privy 10 Livestock pens 14 Abandoned water well
 2 Sewer lines 5 Cess pool 8 Sewage lagoon 11 Fuel storage 15 Oil well/Gas well
 3 Watertight sewer lines 6 Seepage pit 9 Feedyard 12 Fertilizer storage 16 Other (specify below)
 13 Insecticide storage
 Direction from well? Southeast How many feet? 500

FROM	TO	LITHOLOGIC LOG	FROM	TO	PLUGGING INTERVALS
0	20	SILT			
20	25	SILT			
25	30	SILTY CLAY			
30	35	SILT			
35	40	SANDY CLAY			
40	45	SILTY CLAY			
45	50	SANDY CLAY			
50	60	DARK REDDISH BROWN			
60	70	REDDISH BROWN			
70	80	LIGHT REDDISH BROWN			MW-18
80	90	SAND			
90	100	LEAN SAND			
100	110	SILTY SAND			
110	135	SAND			

7 CONTRACTOR'S OR LANDOWNER'S CERTIFICATION: This water well was (1) constructed, (2) reconstructed, or (3) plugged under my jurisdiction and was completed on (mo/day/year) and this record is true to the best of my knowledge and belief. Kansas Water Well Contractor's License No. . . . 590 This Water Well Record was completed on (mo/day/yr) under the business name of by (signature) *Wesley B. Trehs*