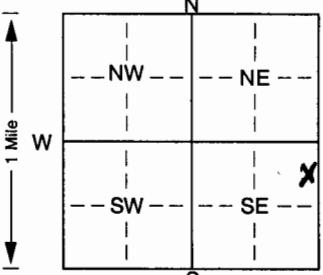


MW-18

1 LOCATION OF WATER WELL: Fraction NE SE 1/4 NE 1/4 SE 1/4 Section Number 3 Township Number T 11 S Range Number R 32 EW
 County: Logan
 Distance and direction from nearest town or city street address of well if located within city?
IN OAKLEY KS, S 2nd Street and Freeman Ave

2 WATER WELL OWNER: Great Western Tire Coastal Mart #2526
 RR#, St. Address, Box #: 319 East Front Street Board of Agriculture, Division of Water Resources
 City, State, ZIP Code: Oakley, KS 67748 Application Number:

3 LOCATE WELL'S LOCATION WITH AN "X" IN SECTION BOX:  4 DEPTH OF COMPLETED WELL: 137 ft. ELEVATION: 2913.43
 Depth(s) Groundwater Encountered 1. 100 ft. 2. 100 ft. 3. 100 ft.
 WELL'S STATIC WATER LEVEL: 119.30 ft. below land surface measured on mo/day/yr 7-15-04
 Pump test data: Well water was _____ ft. after _____ hours pumping _____ gpm
 Est. Yield _____ gpm; Well water was _____ ft. after _____ hours pumping _____ gpm
 Bore Hole Diameter: 8 in. to _____ ft., and _____ in. to _____ ft.
 WELL WATER TO BE USED AS: 5 Public water supply 8 Air conditioning 11 Injection well
 1 Domestic 3 Feedlot 6 Oil field water supply 9 Dewatering 12 Other (Specify below)
 2 Irrigation 4 Industrial 7 Domestic (lawn & garden) 10 Monitoring well MW-18
 Was a chemical/bacteriological sample submitted to Department? Yes. _____ No. X; If yes, mo/day/yr sample was submitted
 Water Well Disinfected? Yes _____ No X

5 TYPE OF BLANK CASING USED: 1 Steel 3 RMP (SR) 5 Wrought iron 8 Concrete tile CASING JOINTS: Glued _____ Clamped _____
2 PVC 4 ABS 6 Asbestos-Cement 9 Other (specify below) Welded _____
 7 Fiberglass Threaded X
 Blank casing diameter 4" in. to 0 ft., Dia 4" in. to 1.07 ft., Dia _____ in. to _____ ft.
 Casing height above land surface -0.32 in., weight _____ lbs./ft. Wall thickness or gauge No. _____
 TYPE OF SCREEN OR PERFORATION MATERIAL: 7 PVC 10 Asbestos-cement
 1 Steel 3 Stainless steel 5 Fiberglass 8 RMP (SR) 11 Other (specify) _____
 2 Brass 4 Galvanized steel 6 Concrete tile 9 ABS 12 None used (open hole)

SCREEN OR PERFORATION OPENINGS ARE: 1 Continuous slot 3 Mill slot 0.020" 5 Gauzed wrapped 8 Saw cut 11 None (open hole)
 2 Louvered shutter 4 Key punched 6 Wire wrapped 9 Drilled holes AUG 30 2004
 7 Torch cut 10 Other (specify) _____ ft.
 SCREEN-PERFORATED INTERVALS: From 1.07 ft. to 1.37 ft., From _____ ft. to _____ ft.
 GRAVEL PACK INTERVALS: From 1.02 ft. to 1.37 ft., From _____ ft. to _____ ft.

6 GROUT MATERIAL: 1 Neat cement 2 Cement grout 3 Bentonite 4 Other sand 102-137
 Grout Intervals: From 0 ft. to 2.0 ft., From 2.0 ft. to 1.00 ft., From 1.00 ft. to 1.02 ft.
 What is the nearest source of possible contamination:
 1 Septic tank 4 Lateral lines 7 Pit privy 10 Livestock pens 14 Abandoned water well
 2 Sewer lines 5 Cess pool 8 Sewage lagoon 11 Fuel storage 15 Oil well/Gas well
 3 Watertight sewer lines 6 Seepage pit 9 Feedyard 12 Fertilizer storage 16 Other (specify below)
 Direction from well? _____ How many feet? _____

FROM	TO	LITHOLOGIC LOG	FROM	TO	PLUGGING INTERVALS
0	2.0	Sandy silt, brown, slightly clayey, fine to coarse sand, no odor	65.0	87.0	clay stringers, no odor
2.0	21.0	Sandy silt, lt brn, very fine sand, no odor	87.0	106.0	Clay, olive to brown, w/ white caliche, no odor
21.0	25.0	Clayey silt, lt brn, fine sand, no odor			Sand, med to very coarse, poorly sorted, subrounded to angular, no odor
25.0	38.0	Clay, olive, lg pockets of caliche, some fine sand, no odor	106.0	110.0	Clay, brown, some med sand & caliche, no odor
38.0	40.0	Sand, med to coarse w/ small gravel, poorly sorted, no odor	110.0	132.0	Sand, med to very coarse, some small gravel, poorly sorted, subrounded to angular, few clay lenses, no odor
40.0	52.0	Sand, lt brn, very fine to med sand, small caliche nodules, clay stringers, no odor	132.0	137.0	Clay, brown, some fine to coarse sand, no odor
52.0	58.0	Clay, brn to olive, some caliche & med. to coarse sand, no odor			
58.0	65.0	Sand, med to very coarse w/ small gravel, poorly sorted, rounded to angular			

7 CONTRACTOR'S OR LANDOWNER'S CERTIFICATION: This water well was (1) constructed, (2) reconstructed, or (3) plugged under my jurisdiction and was completed on (mo/day/year) 7-15-04 and this record is true to the best of my knowledge and belief. Kansas Water Well Contractor's Licence No. #554 This Water Well Record was completed on (mo/day/yr) 8/18/04 under the business name of Water Pump & Well by (signature) [Signature]