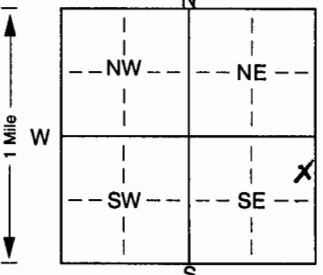


MW-19

1 LOCATION OF WATER WELL: Fraction NE 1/4 NE 1/4 SE 1/4 Section Number 3 Township Number T 11 S R 32 E Range Number 32 E
 County: Logan
 Distance and direction from nearest town or city street address of well if located within city?
IN Oakley KS, S 2nd Street and Freeman Ave.

2 WATER WELL OWNER: Great Western Tire / Coastal Matt #2526
 RR#, St. Address, Box #: 319 East Front Street Board of Agriculture, Division of Water Resources
 City, State, ZIP Code: 1 Oakley KS 67748 Application Number:

3 LOCATE WELL'S LOCATION WITH AN "X" IN SECTION BOX:

 4 DEPTH OF COMPLETED WELL: 135 ft. ELEVATION: 2915.59
 Depth(s) Groundwater Encountered: 1 ft. 2. ft. 3. ft.
 WELL'S STATIC WATER LEVEL: 119.7 ft. below land surface measured on mo/day/yr 7-16-04
 Pump test data: Well water was _____ ft. after _____ hours pumping _____ gpm
 Est. Yield _____ gpm: Well water was _____ ft. after _____ hours pumping _____ gpm
 Bore Hole Diameter: 8 in. to _____ ft., and _____ in. to _____ ft.
 WELL WATER TO BE USED AS:
 5 Public water supply 8 Air conditioning 11 Injection well
 1 Domestic 3 Feedlot 6 Oil field water supply 9 Dewatering 12 Other (Specify below)
 2 Irrigation 4 Industrial 7 Domestic (lawn & garden) 10 Monitoring well M.W.-19
 Was a chemical/bacteriological sample submitted to Department? Yes _____ No X; If yes, mo/day/yr sample was submitted
 Water Well Disinfected? Yes _____ No X

5 TYPE OF BLANK CASING USED:
 1 Steel 3 RMP (SR) 5 Wrought iron 8 Concrete tile CASING JOINTS: Glued _____ Clamped _____
 2 PVC 4 ABS 6 Asbestos-Cement 9 Other (specify below) Welded _____
 7 Fiberglass Threaded X
 Blank casing diameter: 4 in. to 0 ft., Dia: 4 in. to 10.5 ft., Dia: _____ in. to _____ ft.
 Casing height above land surface: -0.54 in., weight _____ lbs./ft. Wall thickness or gauge No. _____
 TYPE OF SCREEN OR PERFORATION MATERIAL:
 1 Steel 3 Stainless steel 5 Fiberglass 8 RMP (SR) 10 Asbestos-cement
 2 Brass 4 Galvanized steel 6 Concrete tile 9 ABS 11 Other (specify) _____
 12 None used (open hole)
 SCREEN OR PERFORATION OPENINGS ARE:
 1 Continuous slot 3 Mill slot 0.020" 5 Gauzed wrapped 8 Saw cut 11 None (open hole)
 2 Louvered shutter 4 Key punched 6 Wire wrapped 9 Drilled holes
 7 Torch cut 10 Other (specify) _____ ft.
 SCREEN-PERFORATED INTERVALS: From 10.5 ft. to 13.5 ft., From _____ ft. to _____ ft.
 From _____ ft. to _____ ft., From _____ ft. to _____ ft.
 GRAVEL PACK INTERVALS: From _____ ft. to _____ ft., From _____ ft. to _____ ft.
 From 10.2 ft. to 13.5 ft., From _____ ft. to _____ ft.

6 GROUT MATERIAL: 0 Neat cement 2 Cement grout 3 Bentonite 4 Other sand 102-135
 Grout Intervals: From 0 ft. to 2.0 ft., From 2.0 ft. to 1.00 ft., From 1.00 ft. to 10.2 ft.
 What is the nearest source of possible contamination:
 1 Septic tank 4 Lateral lines 7 Pit privy 10 Livestock pens 14 Abandoned water well
 2 Sewer lines 5 Cess pool 8 Sewage lagoon 11 Fuel storage 15 Oil well/Gas well
 3 Watertight sewer lines 6 Seepage pit 9 Feedyard 12 Fertilizer storage 16 Other (specify below)
 13 Insecticide storage _____
 Direction from well? _____ How many feet? _____

FROM	TO	LITHOLOGIC LOG	FROM	TO	PLUGGING INTERVALS
0	2.0	Sandy silt, brn fine to coarse sand, no odor	89.0	103.0	Sand, med to very coarse w/ gravel, poorly sorted, rounded to angular, no odor
2.0	22.0	Sandy silt, lt yellowish brn, very fine to fine sand, no odor	103.0	110.00	Clay, light brown, some fine to med sand and white caliche, no odor
22.0	34.0	Clay, olive w/ pockets of white caliche, sandy fine to med sand, no odor	111.0	132.0	Sand med to very coarse, poorly sorted rounded to angular, no odor.
34.0	36.0	Caliche, white, hard, no odor	132.0	135.0	Clay, lt brn, some caliche, no odor
36.0	53.0	Sand fine to med w/ some coarse grains, fairly well sorted, no odor			
53.0	59.0	Clay, brown, some fine to med. sand, some caliche, no odor			RECEIVED
59.0	65.0	Sand med to very coarse, poorly sorted, subrounded to angular, no odor			AUG 30 2004
65.0	89.0	Clay, light brown, some fine to med. sand, no odor			BUREAU OF WATER

7 CONTRACTOR'S OR LANDOWNER'S CERTIFICATION: This water well was (1) constructed, (2) reconstructed, or (3) plugged under my jurisdiction and was completed on (mo/day/year) 7-16-04 and this record is true to the best of my knowledge and belief. Kansas Water Well Contractor's Licence No. #554 This Water Well Record was completed on (mo/day/yr) 8-18-04 under the business name of Walter Pump & Well by (signature) Walter Pen