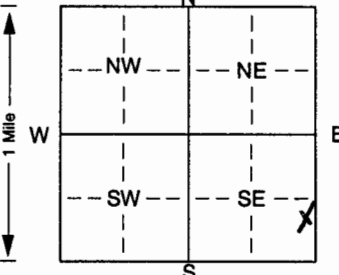


1 LOCATION OF WATER WELL: Fraction SE 1/4 NE 1/4 SE 1/4 Section Number 3 Township Number T 11 S Range Number R 32 EW  
 County: Logan

Distance and direction from nearest town or city street address of well if located within city?  
208 S. Freeman Ave Oakley KS

2 WATER WELL OWNER: Great Western Tire/Coastal Mart #2526  
 RR#, St. Address, Box #: 319 East Front Street Board of Agriculture, Division of Water Resources  
 City, State, ZIP Code: Oakley, KS 67748 Application Number: \_\_\_\_\_

3 LOCATE WELL'S LOCATION WITH AN "X" IN SECTION BOX:  
  
 4 DEPTH OF COMPLETED WELL: 136.0 ft. ELEVATION: 2912.45  
 Depth(s) Groundwater Encountered 1. \_\_\_\_\_ ft. 2. \_\_\_\_\_ ft. 3. \_\_\_\_\_ ft.  
 WELL'S STATIC WATER LEVEL: 117.92 ft. below surface measured on mo/day/yr 7-16-04  
 Pump test data: Well water was \_\_\_\_\_ ft. after \_\_\_\_\_ hours pumping \_\_\_\_\_ gpm  
 Est. Yield \_\_\_\_\_ gpm Well water was \_\_\_\_\_ ft. after \_\_\_\_\_ hours pumping \_\_\_\_\_ gpm  
 Bore Hole Diameter: 8 in. to \_\_\_\_\_ ft., and \_\_\_\_\_ in. to \_\_\_\_\_ ft.  
 WELL WATER TO BE USED AS:  
 5 Public water supply 8 Air conditioning 11 Injection well  
 1 Domestic 3 Feedlot 6 Oil field water supply 9 Dewatering 12 Other (Specify below)  
 2 Irrigation 4 Industrial 7 Domestic (lawn & garden) 10 Monitoring well MW-20  
 Was a chemical/bacteriological sample submitted to Department? Yes \_\_\_\_\_ No X; If yes, mo/day/yr sample was submitted \_\_\_\_\_  
 Water Well Disinfected? Yes \_\_\_\_\_ No X

5 TYPE OF BLANK CASING USED:  
 1 Steel 2 PVC 3 RMP (SR) 4 ABS 5 Wrought iron 6 Asbestos-Cement 7 Fiberglass 8 Concrete tile 9 Other (specify below)  
 Blank casing diameter 4 in. to \_\_\_\_\_ ft., Dia \_\_\_\_\_ in. to \_\_\_\_\_ ft., Dia \_\_\_\_\_ in. to \_\_\_\_\_ ft.  
 Casing height above land surface: 0.32 in., weight \_\_\_\_\_ lbs./ft. Wall thickness or gauge No. \_\_\_\_\_  
 TYPE OF SCREEN OR PERFORATION MATERIAL:  
 1 Steel 2 Brass 3 Stainless steel 4 Galvanized steel 5 Fiberglass 6 Concrete tile 7 PVC 8 RMP (SR) 9 ABS 10 Asbestos-cement 11 Other (specify) 12 None used (open hole)  
 SCREEN OR PERFORATION OPENINGS ARE:  
 1 Continuous slot 2 Louvered shutter 3 Mill slot 0.020" 4 Key punched 5 Gauzed wrapped 6 Wire wrapped 7 Torch cut 8 Saw cut 9 Drilled holes 10 Other (specify) RECEIVED  
 SCREEN-PERFORATED INTERVALS: From 106 ft. to 136 ft. From \_\_\_\_\_ ft. to \_\_\_\_\_ ft.  
 GRAVEL PACK INTERVALS: From 102 ft. to 136 ft. From \_\_\_\_\_ ft. to \_\_\_\_\_ ft.

6 GROUT MATERIAL: 1 neat cement 2 cement grout 3 Bentonite 4 other Sand 102 Ft. to 136 Ft.  
 Grout Intervals: From 0 ft. to 2.0 ft., From 2.0 ft. to 100 ft., From 100 ft. to 102 ft.  
 What is the nearest source of possible contamination:  
 1 Septic tank 2 Sewer lines 3 Watertight sewer lines 4 Lateral lines 5 Cess pool 6 Seepage pit 7 Pit privy 8 Sewage lagoon 9 Feedyard 10 Livestock pens 11 Fuel storage 12 Fertilizer storage 13 Insecticide storage 14 Abandoned water well 15 Oil well/Gas well 16 Other (specify below)  
 Direction from well? \_\_\_\_\_ How many feet? \_\_\_\_\_

FROM	TO	LITHOLOGIC LOG	FROM	TO	PLUGGING INTERVALS
0	2.0	Sandy Clay, brown, fine to very coarse sand, random gravel, no odor	52.0	57.0	Sandy Clay, light brown, med sand, white caliche, no odor
2.0	16.0	Sandy Silt, yellowish brown, very fine to fine sand, no odor	57.0	67.0	Sand, fine to very coarse, some gravel brown clay, white caliche lenses, no odor
16.0	23.0	Silty Clay, light brown, some fine sand, no odor	67.0	82.0	Clay, light brown, some fine toned sand, some white caliche, no odor
23.0	30.0	Clay, olive, some fine to med sand & pockets of sandy white caliche, no odor	82.0	101.0	Sand, med to very coarse, poorly sorted, subrounded to angular, light brown clay lenses, no odor
30.0	35.0	Caliche, white, hard, w/ olive clay stringer, no odor	101.0	108.0	Clay, light brown, sandy, med sand, some caliche, no odor
35.0	46.0	Sand, fine to very coarse grains, poorly sorted, subrounded to angular, caliche lens, no odor	108.0	130	Sand, med to coarse, poorly sorted, rounded to angular, some gravel, no odor
46.0	52.0	Sand, fine toned, well sorted, no odor	130	136	Clay and caliche

7 CONTRACTOR'S OR LANDOWNER'S CERTIFICATION: This water well was 1 constructed, 2 reconstructed, or 3 plugged under my jurisdiction and was completed on (mo/day/year) 7-16-04 and this record is true to the best of my knowledge and belief. Kansas Water Well Contractor's Licence No. #554 This Water Well Record was completed on (mo/day/yr) 8-17-04 under the business name of Waffle Pump Well by (signature) [Signature]