

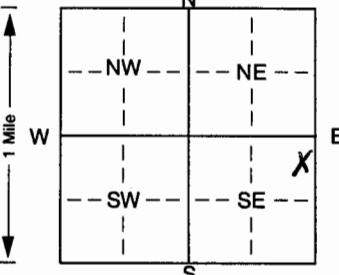
MW-22

00330398

1 LOCATION OF WATER WELL: Fraction SW NE 1/4 NE 1/4 SE 1/4 Section Number 3 Township Number T 11 S R 32 Range Number EW  
 County: Logan Distance and direction from nearest town or city street address of well if located within city? 324 East Front Street, Oakley KS

EIDASO CORD  
2 N. NEVADA  
COLO. SP., CO 80903

2 WATER WELL OWNER: Great Western Fire/Coastal Mart #2526  
 RR#, St. Address, Box #: 319 East Front Street  
 City, State, ZIP Code: Oakley KS 67748  
 Board of Agriculture, Division of Water Resources  
 Application Number: 7-21-04

3 LOCATE WELL'S LOCATION WITH AN "X" IN SECTION BOX:  
  
 4 DEPTH OF COMPLETED WELL: 135.0 ft. ELEVATION: 2919.02  
 Bore Hole Diameter: 8 in. to 8 in. to 8 in. to 8 in.  
 WELL WATER TO BE USED AS:  
 5 Public water supply 8 Air conditioning 11 Injection well  
 1 Domestic 3 Feedlot 6 Oil field water supply 9 Dewatering 12 Other (Specify below)  
 2 Irrigation 4 Industrial 7 Domestic (lawn & garden) 10 Monitoring well MW-22  
 Was a chemical/bacteriological sample submitted to Department? Yes X No X; If yes, mo/day/yr sample was submitted  
 Water Well Disinfected? Yes X No X

5 TYPE OF BLANK CASING USED:  
 1 Steel 2 PVC 3 RMP (SR) 4 ABS 5 Wrought iron 6 Asbestos-Cement 7 Fiberglass 8 Concrete tile 9 Other (specify below)  
 Blank casing diameter: 4 in. to 0 ft., Dia. 4 in. to 10.5 ft., Dia. 4 in. to 10.5 ft., Dia. 4 in. to 10.5 ft., Dia.  
 Casing height above land surface: -0.26 in., weight 4 lbs./ft. Wall thickness or gauge No. X  
 TYPE OF SCREEN OR PERFORATION MATERIAL:  
 1 Steel 2 Brass 3 Stainless steel 4 Galvanized steel 5 Fiberglass 6 Concrete tile 7 PVC 8 RMP (SR) 9 ABS 10 Asbestos-cement 11 Other (specify) 12 None used (open hole)  
 SCREEN OR PERFORATION OPENINGS ARE:  
 1 Continuous slot 2 Louvered shutter 3 Mill slot 0.020" 4 Key punched 5 Gauzed wrapped 6 Wire wrapped 7 Torch cut 8 Saw cut 9 Drilled holes 10 Other (specify) 11 None (open hole)  
 SCREEN-PERFORATED INTERVALS: From 10.5 ft. to 13.5 ft. From 102 ft. to 135 ft.  
 GRAVEL PACK INTERVALS: From 102 ft. to 135 ft.

RECEIVED  
 AUG 30 2004  
 BUREAU OF WATER

6 GROUT MATERIAL: 1 Neat cement 2 Cement grout 3 Bentonite 4 other Sand 102' to 135'  
 Grout Intervals: From 0 ft. to 2.0 ft., From 2.0 ft. to 100.0 ft., From 100.0 ft. to 102.0 ft.  
 What is the nearest source of possible contamination:  
 1 Septic tank 2 Sewer lines 3 Watertight sewer lines 4 Lateral lines 5 Cess pool 6 Seepage pit 7 Pit privy 8 Sewage lagoon 9 Feedyard 10 Livestock pens 11 Fuel storage 12 Fertilizer storage 13 Insecticide storage 14 Abandoned water well 15 Oil well/Gas well 16 Other (specify below)  
 Direction from well? \_\_\_\_\_ How many feet? \_\_\_\_\_

FROM	TO	LITHOLOGIC LOG	FROM	TO	PLUGGING INTERVALS
0	0.5'	Concrete	47.0	52.0	Clay, light brown, w/white caliche & med sand, no odor
0.5'	20.0	Sandy silt, yellowish brown, very fine to fine sand, loess deposit, no odor	52.0	71.0	Clay, light brown, some fine sand, no odor
20.0	24.0	Clay, light brown, w/some fine sand & pockets of hard white caliche, no odor	71.0	88.0	Clay, light brown w/white caliche & med sand, no odor
24.0	30.0	Clay, light brown, w/some fine sand & pockets of hard white caliche, no odor	88.0	94.0	Sand, med to very coarse, light brown clay stringer w/ med sand, poorly sorted subrounded-angular
30.0	35.0	Sandy clay, lt brown w/ fine sand stringers & hard white caliche (w/blk & purple mineral dep) no odor	94.0	102.0	Sandy clay, light brown, med sand, no odor
35.0	38.5	Clay, olive, some reddish brn clay, friable, possible ash deposit, no odor	102.0	106.0	Med sand w/ light brown clay, no odor
38.5	41.0	Sand, med to very coarse, w/hard white caliche light tan clay, no odor	106.0	112.0	Sandy clay, light brown, med grain, no odor
41.0	47.0	Sand, med to very coarse, some small gravel, poorly sorted, subrounded to angular, no odor	112.0	135.0	Sand, med to very coarse, poorly sorted, subrounded to angular, no odor

7 CONTRACTOR'S OR LANDOWNER'S CERTIFICATION: This water well was (1) constructed, (2) reconstructed, or (3) plugged under my jurisdiction and was completed on (mo/day/year) 7-21-04 and this record is true to the best of my knowledge and belief. Kansas Water Well Contractor's Licence No. #554 This Water Well Record was completed on (mo/day/yr) 8/18/04 under the business name of Wooftee Pump & Well by (signature) Wojan