

WATER WELL PLUGGING RECORD


FORM WWC-5P

KSA 82a-1212

1 LOCATION OF WATER WELL:	Fraction	Section Number	Township Number	Range Number
County: Logan	SW 1/4 SW 1/4 SW 1/4	2	11	32

Distance and direction from nearest town or city street address of "well" if located within city?
JJ OIL (OAKLEY)

2 WATER WELL OWNER: **J J OIL**
 RR#, St. Address, Box # _____
 City, State, ZIP Code : **OAKLEY, KS 67748** **MW # 8** Board of Agriculture, Division of Water Resources
 Application Number: _____

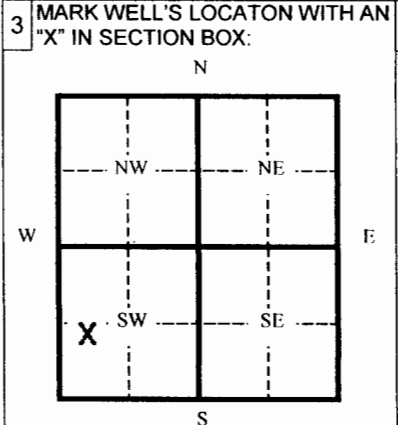

4 DEPTH OF WELL 55 ft.
 WELL'S STATIC WATER LEVEL _____ ft.
 WELL WAS USED AS:
 1 Domestic _____ 5 Public Water Supply _____ 9 Dewatering _____
 2 Irrigation _____ Oil Field Water Supply _____ **10** Monitoring Well _____
 3 Feedlot _____ 7 Lawn and Garden (domestic) _____ 11 Injection Well _____
 4 Industrial _____ 8 Air Conditioning _____ 12 Other _____
 Was a chemical/bacteriological sample submitted to Department? Yes _____ No **X**
 If yes, mo/day/yr sample was submitted _____
 Water Well Disinfected: Yes **X** No _____

5 TYPE OF BLANK CASING USED:
 1 Steel _____ 3 RMP (SR) _____ 5 Wrought _____ 7 Fiberglass _____ 9 Other (specify below) _____
2 PVC _____ 4 ABC _____ 6 Asbestos-Cement _____ 8 Concrete Tile _____
 Blank casing diameter 2 in. Was casing pulled? Yes _____ No _____ If yes, how much _____
 Casing height above or below land surface -36 in.

6 GROUT PLUG MATERIAL: 1 Neat cement _____ 2 Cement grout _____ 3 Bentonite _____ 4 Other _____
 Grout Plug Intervals From _____ ft. to _____ ft. From _____ ft. to _____ ft. From _____ ft. to _____ ft.
 What is the nearest source of possible contamination:
 1 Septic tank _____ 6 Seepage pit _____ 11 Fuel storage _____ 16 Other (specify below) _____
 2 Sewer lines _____ 7 Pit privy _____ 12 Fertilizer storage _____
 3 Watertight sewer lines _____ 8 Sewage lagoon _____ 13 Insecticide storage _____
 4 Lateral lines _____ 9 Feedyard _____ 14 Abandoned water well _____
 5 Cess Pool _____ 10 Livestock pens _____ 15 Oil well/ Gas well _____
 Direction from well? _____ How many feet? _____

FROM	TO	CODE	PLUGGING MATERIALS
55	2		BENTONITE
2	0		TOPSOIL

Jetted 2" well out to 55'. Had dirt & trash from 12' To 20' & from 20 -55 med sand & gravel. Could not go any deeper so, plugged with Bentonite.

7 CONTRACTOR'S OR LANDOWNER'S CERTIFICATION: This water well was plugged under my jurisdiction and was completed on (mo/day/yr) **10-04-04** and this record is true to the best of my knowledge and belief. Kansas Water Well Contractor's License No. **554** This Water Well Record was completed on (mo/day/yr) _____ under the business name of **Woofter Pump & Well, Inc.** by (signature) _____

INSTRUCTIONS: Please fill in blanks and circle the correct answers. Send three copies to Kansas Department of Health and Environment, Bureau of Water, Topeka, Kansas 66620-0001. Telephone: 785-296-3565. Send one to Water Well Owner and retain one for your records.