


1 LOCATION OF WATER WELL: Fraction NE 1/4 NE 1/4 NW 1/4 Section Number 8 Township Number T 11 S Range Number R 32 EW
 County: Logan

Distance and direction from nearest town or city street address of well if located within city?
1 1/2 Miles West of Oakley, Kansas

2 WATER WELL OWNER: Herman Schippers
 RR#, St. Address, Box # : _____ Board of Agriculture, Division of Water Resources
 City, State, ZIP Code : Oakley, Kansas Application Number: 20709

3 LOCATE WELL'S LOCATION WITH AN "X" IN SECTION BOX:

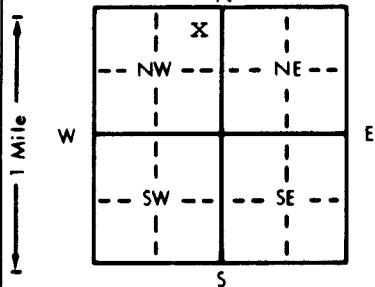

4 DEPTH OF COMPLETED WELL: 211 ft. ELEVATION: _____
 Depth(s) Groundwater Encountered 1. _____ ft. 2. _____ ft. 3. _____ ft.
 WELL'S STATIC WATER LEVEL 123 ft. below land surface measured on mo/day/yr 4-3-89
 Pump test data: Well water was _____ ft. after _____ hours pumping _____ gpm
 Est. Yield 425 gpm: Well water was _____ ft. after _____ hours pumping _____ gpm
 Bore Hole Diameter 28 in. to 211 ft., and _____ in. to _____ ft.
 WELL WATER TO BE USED AS: 5 Public water supply 8 Air conditioning 11 Injection well
 1 Domestic 3 Feedlot 6 Oil field water supply 9 Dewatering 12 Other (Specify below)
 2 Irrigation 4 Industrial 7 Lawn and garden only 10 Monitoring well
 Was a chemical/bacteriological sample submitted to Department? Yes _____ No X; If yes, mo/day/yr sample was submitted
 Water Well Disinfected? Yes _____ No X

5 TYPE OF BLANK CASING USED: 5 Wrought iron 8 Concrete tile CASING JOINTS: Glued X Clamped _____
 1 Steel 3 RMP (SR) 6 Asbestos-Cement 9 Other (specify below) Welded _____
 2 PVC 4 ABS 7 Fiberglass _____ Threaded _____
 Blank casing diameter 16 in. to 151 ft., Dia _____ in. to _____ ft., Dia _____ in. to _____ ft.
 Casing height above land surface 18 in., weight 16.4 lbs./ft. Wall thickness or gauge No. .500

TYPE OF SCREEN OR PERFORATION MATERIAL: 7 PVC 10 Asbestos-cement
 1 Steel 3 Stainless steel 5 Fiberglass 8 RMP (SR) 11 Other (specify) _____
 2 Brass 4 Galvanized steel 6 Concrete tile 9 ABS 12 None used (open hole)

SCREEN OR PERFORATION OPENINGS ARE: 5 Gauzed wrapped 8 Saw cut 11 None (open hole)
 1 Continuous slot 3 Mill slot 6 Wire wrapped 9 Drilled holes
 2 Louvered shutter 4 Key punched 7 Torch cut 10 Other (specify) _____

SCREEN-PERFORATED INTERVALS: From 151 ft. to 211 ft., From _____ ft. to _____ ft.
 From _____ ft. to _____ ft., From _____ ft. to _____ ft.
 GRAVEL PACK INTERVALS: From 20 ft. to 21 ft., From _____ ft. to _____ ft.
 From _____ ft. to _____ ft., From _____ ft. to _____ ft.

6 GROUT MATERIAL: 1 Neat cement 2 Cement grout 3 Bentonite 4 Other _____
 Grout Intervals: From 0 ft. to 20 ft., From _____ ft. to _____ ft., From _____ ft. to _____ ft.
 What is the nearest source of possible contamination:
 1 Septic tank 4 Lateral lines 7 Pit privy 10 Livestock pens 14 Abandoned water well
 2 Sewer lines 5 Cess pool 8 Sewage lagoon 11 Fuel storage 15 Oil well/Gas well
 3 Watertight sewer lines 6 Seepage pit 9 Feedyard 12 Fertilizer storage 16 Other (specify below)
 13 Insecticide storage
 Direction from well? East How many feet? 1200

FROM	TO	LITHOLOGIC LOG	FROM	TO	PLUGGING INTERVALS
<u>0</u>	<u>3</u>	<u>Surface</u>	<u>186</u>	<u>190</u>	<u>Clay</u>
<u>3</u>	<u>117</u>	<u>Clay</u>	<u>190</u>	<u>191</u>	<u>Med. sand</u>
<u>117</u>	<u>144</u>	<u>Med. sand</u>	<u>191</u>	<u>201</u>	<u>Clay</u>
<u>144</u>	<u>145</u>	<u>Cemented streaks</u>	<u>201</u>	<u>211</u>	<u>Med. sand</u>
<u>145</u>	<u>148</u>	<u>Med. sand</u>	<u>211</u>	<u>215</u>	<u>Shale</u>
<u>148</u>	<u>155</u>	<u>Caliche</u>			
<u>155</u>	<u>159</u>	<u>Fine-med sand</u>			
<u>159</u>	<u>163</u>	<u>Clay</u>			
<u>163</u>	<u>166</u>	<u>Med sand-couple thin streaks</u>			
<u>166</u>	<u>169</u>	<u>Clay</u>			
<u>169</u>	<u>170</u>	<u>Med. sand</u>			
<u>170</u>	<u>174</u>	<u>Clay</u>			
<u>174</u>	<u>176</u>	<u>Med. sand</u>			
<u>176</u>	<u>182</u>	<u>Clay</u>			
<u>182</u>	<u>186</u>	<u>Med. sand</u>			

7 CONTRACTOR'S OR LANDOWNER'S CERTIFICATION: This water well was (1) constructed, (2) reconstructed, or (3) plugged under my jurisdiction and was completed on (mo/day/year) 4-3-89 and this record is true to the best of my knowledge and belief. Kansas Water Well Contractor's License No. 394 This Water Well Record was completed on (mo/day/yr) 5-18-89 under the business name of Woofter Pump & Well Service by (signature) Walker

INSTRUCTIONS: Use typewriter or ball point pen. PLEASE PRESS FIRMLY and PRINT clearly. Please fill in blanks, underline or circle the correct answers. Send top three copies to Kansas Department of Health and Environment, Bureau of Water Protection, Topeka, Kansas 66620-7320. Telephone: 913-296-5514. Send one to WATER WELL OWNER and retain one for your records.

OFFICE USE ONLY