


1 LOCATION OF WATER WELL: Fraction NW 1/4 SW 1/4 SE 1/4 Section Number 12 Township Number T 11 S Range Number R 32 E W
 County: Logan
 Distance and direction from nearest town or city street address of well if located within city?

2 E 1 S Of Oakley

2 WATER WELL OWNER: Jim Mitten
 RR#, St. Address, Box # : 619 E. 6 Board of Agriculture, Division of Water Resources
 City, State, ZIP Code : Oakley, Ks 67748 Application Number:

3 LOCATE WELL'S LOCATION WITH AN "X" IN SECTION BOX: 4 DEPTH OF COMPLETED WELL 145 ft. ELEVATION:

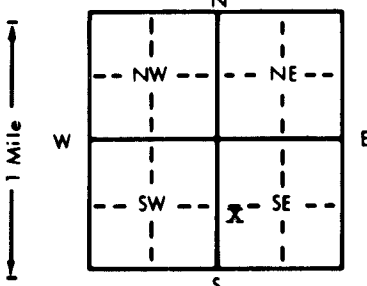

Depth(s) Groundwater Encountered 1. ft. 2. ft. 3. ft.
 WELL'S STATIC WATER LEVEL 93 ft. below land surface measured on mo/day/yr 12-16-87
 Pump test data: Well water was ft. after hours pumping gpm
 Est. Yield gpm: Well water was not tested after hours pumping gpm
 Bore Hole Diameter 8 in. to 145 ft., and in. to ft.
 WELL WATER TO BE USED AS: 5 Public water supply 8 Air conditioning 11 Injection well
 1 Domestic 3 Feedlot 6 Oil field water supply 9 Dewatering 12 Other (Specify below)
 2 Irrigation 4 Industrial 7 Lawn and garden only 10 Observation well Truck wash
 Was a chemical/bacteriological sample submitted to Department? Yes..... No X.....; If yes, mo/day/yr sample was submitted
 Water Well Disinfected? Yes X No

5 TYPE OF BLANK CASING USED: 5 Wrought iron 8 Concrete tile CASING JOINTS: Glued X Clamped
 1 Steel 3 RMP (SR) 6 Asbestos-Cement 9 Other (specify below) Welded
 2 PVC 4 ABS 7 Fiberglass Threaded
 Blank casing diameter in. to 125 ft., Dia in. to ft., Dia in. to ft.
 Casing height above land surface 1 in., weight 4.56 lbs./ft. Wall thickness or gauge No. 320

TYPE OF SCREEN OR PERFORATION MATERIAL: 7 PVC 10 Asbestos-cement
 1 Steel 3 Stainless steel 5 Fiberglass 8 RMP (SR) 11 Other (specify)
 2 Brass 4 Galvanized steel 6 Concrete tile 9 ABS 12 None used (open hole)

SCREEN OR PERFORATION OPENINGS ARE: 5 Gauzed wrapped 8 Saw cut 11 None (open hole)
 1 Continuous slot 3 Mill slot 6 Wire wrapped 9 Drilled holes
 2 Louvered shutter 4 Key punched 7 Torch cut 10 Other (specify)

SCREEN-PERFORATED INTERVALS: From 125 ft. to 145 ft., From ft. to ft.
 From ft. to ft., From ft. to ft.
 GRAVEL PACK INTERVALS: From 18 ft. to 145 ft., From ft. to ft.
 From ft. to ft., From ft. to ft.

6 GROUT MATERIAL: 1 Neat cement 2 Cement grout 3 Bentonite 4 Other
 Grout Intervals: From 5 ft. to 45 ft., From ft. to ft., From ft. to ft.

What is the nearest source of possible contamination:
 1 Septic tank 4 Lateral lines 7 Pit privy 10 Livestock pens 14 Abandoned water well
 2 Sewer lines 5 Cess pool 8 Sewage lagoon 11 Fuel storage 15 Oil well/Gas well
 3 Watertight sewer lines 6 Seepage pit 9 Feedyard 12 Fertilizer storage 16 Other (specify below)
 13 Insecticide storage
 Direction from well? southeast How many feet? 110

FROM	TO	LITHOLOGIC LOG	FROM	TO	LITHOLOGIC LOG
0	31	top soil			
31	50	sandy clay			
50	62	sand and clay strips			
62	69	sand clay			
69	85	sand rock and sand strips			
85	105	sand			
105	109	clay			
109	112	sand rock hard			
112	122	sandy clay			
122	137	sand and clay strips			
137	142	good sand			
142	145	oker and shale			

7 CONTRACTOR'S OR LANDOWNER'S CERTIFICATION: This water well was (1) constructed, (2) reconstructed, or (3) plugged under my jurisdiction and was completed on (mo/day/year) 12-16-87 and this record is true to the best of my knowledge and belief. Kansas
 Water Well Contractor's License No. 139 This Water Well Record was completed on (mo/day/yr) 7-9-88
 under the business name of Bartell Drilling by (signature) Joyce Bartell

INSTRUCTIONS: Use typewriter or ball point pen. PLEASE PRESS FIRMLY and PRINT clearly. Please fill in blanks, underline or circle the correct answers. Send top three copies to Kansas Department of Health and Environment, Bureau of Water Protection, Topeka, Kansas 66620-7320, Telephone: 913-862-9360. Send one to WATER WELL OWNER and retain one for your records.

OFFICE USE ONLY
T
R
EW
SEC.
1/4
1/4
1/4