USE TYPEWRITER OR BALL POINT PEN-PRESS FIRMLY, PRINT CLEARLY.

WATER WELL RECORD
KSA 82a-1201-1215

T	R	EW	sec 1/4	1/4	1/4	No.

Kansas State Dept. Of Health
(Water Well Contractors)
Forbes-Bldg. 740
Topeka, Kansas 66620

1 Location of well:	County	Township name	Fraction	Section number	Town number	Range number
	Logan	~~SE NW NW~~	SE NW NW	18	T 11 S	R 32 W

Distance and direction from nearest town or city: 4 west 1½ south Of Oakley, Ks.

Street address of well location if in city:

3 Owner of well: Don Lintel
Address: RR 1 Oakley, Ks.

Locate with "X" in section below:

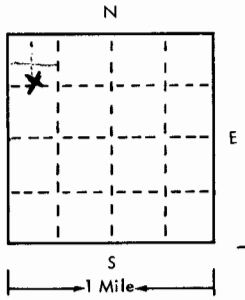

Sketch map:

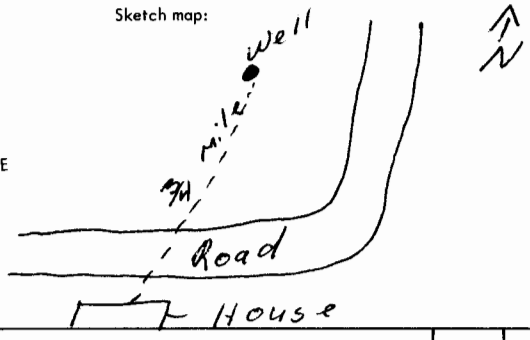

4 Well depth: 175 ft. Date of completion 10-31-75
Well diameter 28 in.

5 ☐ Cable tool ☐ Rotary ☐ Driven ☐ Dug ☐ Hollow rod ☐ Jetted ☐ Bored ☒ Reverse rotary

6 Use: ☐ Domestic ☐ Public supply ☐ Industry ☒ Irrigation ☐ Air conditioning ☐ Commercial ☐ Test well ☐

7 Casing: Material Steel Height: above/below
Threaded ☐ Welded ☒ Surface 12 in.
Diam. 12¾ in. to 175 ft. depth Weight 25.46 lbs./ft. .165
___ in. to ___ ft. depth Drive shoe? ☐ Yes ☒ No

2 Type and color of material	From	To
Topsoil, Clay Sility	0	75
Sandy clay, Sandstone (brown & white)	75	80
Med Gravel, Streak sandstone sandy clay	80	92
Sandy Clay, trace Sandstone (brown white	92	104
Med gravel, Fine sand, trace Sandy clay	104	120
Sandy clay, Sandstone, trace rock, Med gravel	120	142
Fine sand, Sandy clay, Med gravel	142	151
Fine sand, Med gravel, streak Sandy clay	151	158
Ocher, shale (yellow, blue)	158	175
Broke 156		
(use a second sheet if needed)		

8 Screen:
Manufacturer W. A. Brown
Type Slot Dia. 12¾
Slot/~~gauze~~ 40 Length 64' 5"
Set between 110 ft. and 175 ft. 7"
Fittings:
Gravel pack ☒ Yes ☐ No Size range of material ~~40~~ 1/4

9 Static water level:
100 ft. below land surface Date 10-31-75

10 Pumping level below land surfaces:
165 ft. after 8 hrs. pumping 430 g.p.m.
___ ft. after ___ hrs. pumping ___ g.p.m.
Estimated maximum yield 430 g.p.m.

11 Water sample submitted:
☐ Yes ☒ No Date ___

12 Well head completion:
☐ Pitless adapter None ☐ Inches above grade

13 Well grouted? ☒ Yes ☐ No
☒ Neat cement ☐ Bentonite ☐ ___
Depth: From 0 ft. to 10 ft.

14 Nearest source of possible contamination:
ft. ¾ Mile Direction SE Type Septic Tank
Well disinfected upon completion? ☒ Yes ☐ No

15 Pump: Used ☐ Not installed
Manufacturer's name Westeren Land Roller
Model number ___ HP ___ Volts ___
Length of drop pipe 160 ft. capacity 430 g.m.p.
Type:
☐ Submersible ☒ Turbine
☐ Jet ☐ Reciprocating
☐ Certrifugal ☐ Other

16 Remarks: elevation 3070 (Topo)

3070
20
3050

Topography:
☐ Hill
☒ Slope
☐ Upland
☐ Valley

17 Water well contractor's certification:
This well was drilled under my jurisdiction and this report is true to the best of my knowledge and belief.
Red Tiger Irrigation 125
Business name License No.
Address Colby Ks
Signed [signature] Date 11-1-75
Authorized representative

11 32 W 18 SENWNW

Forward the white, blue and pink copies to the Kansas State Dept. Of Health.

Form WWC-5

677-H