


1 LOCATION OF WATER WELL: Fraction NE SE 1/4 NE 1/4 SE 1/4 Section Number 3 Township Number T 11 S Range Number R 32 E (W)
 County: LOGAN

Distance and direction from nearest town or city street address of well if located within city?
S. 2nd St + Freeman Ave Oakley, KS

2 WATER WELL OWNER: Great Western Tire
 RR#, St. Address, Box # : 319 E. Front St
 City, State, ZIP Code : Oakley, KS 67748
 Board of Agriculture, Division of Water Resources
 Application Number:

3 LOCATE WELL'S LOCATION WITH AN "X" IN SECTION BOX: 4 DEPTH OF COMPLETED WELL 133 ft. ELEVATION: 3051.47 TOG

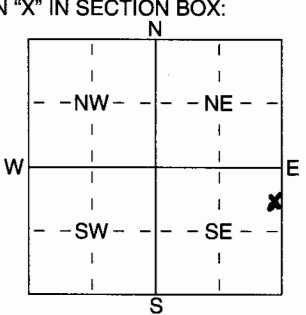

Depth(s) Groundwater Encountered 1 121.59 ft. 2 ft. 3 10/25/05 ft.
 WELL'S STATIC WATER LEVEL ft. below land surface measured on mo/day/yr
 Pump test data: Well water was ft. after hours pumping gpm
 Est. Yield gpm: Well water was ft. after hours pumping gpm
 WELL WATER TO BE USED AS:
 1 Domestic 2 Irrigation 3 Feedlot 4 Industrial 5 Public water supply 6 Oil field water supply 7 Domestic (lawn & garden) 8 Air conditioning 9 Dewatering 10 Monitoring well IW-8 11 Injection well 12 Other (Specify below)

Was a chemical/bacteriological sample submitted to Department? Yes No X; If yes, mo/day/yrs sample was submitted
 Water Well Disinfected? Yes No

5 TYPE OF BLANK CASING USED:
 1 Steel 2 PVC 3 RMP (SR) 4 ABS 5 Wrought iron 6 Asbestos-Cement 7 Fiberglass 8 Concrete tile 9 Other (specify below)
 CASING JOINTS: Glued Clamped Welded Threaded X

Blank casing diameter in. to ft., Dia in. to ft., Dia in. to ft.
 Casing height above land surface -0.44 in., weight lbs./ft. Wall thickness or gauge No.

TYPE OF SCREEN OR PERFORATION MATERIAL:
 1 Steel 2 Brass 3 Stainless Steel 4 Galvanized Steel 5 Fiberglass 6 Concrete tile 7 PVC 8 RMP (SR) 9 ABS 10 Asbestos-Cement 11 Other (Specify) 12 None used (open hole)

SCREEN OR PERFORATION OPENINGS ARE:
 1 Continuous slot 2 Louvered shutter 3 Mill slot 4 Key punched 5 Gauzed wrapped 6 Wire wrapped 7 Torch cut 8 Saw cut 9 Drilled holes 10 Other (specify) 11 None (open hole)

SCREEN-PERFORATED INTERVALS: From 131 ft. to 133 ft., From ft. to ft.
 GRAVEL PACK INTERVALS: From 129 ft. to 133 ft., From ft. to ft.

6 GROUT MATERIAL: 1 Neat cement 2 Cement grout 3 Bentonite 4 Other
 Grout Intervals: From 0 ft. to 129 ft., From ft. to ft., From ft. to ft.

What is the nearest source of possible contamination:
 1 Septic tank 2 Sewer lines 3 Watertight sewer lines 4 Lateral lines 5 Cess pool 6 Seepage pit 7 Pit privy 8 Sewage lagoon 9 Feedyard 10 Livestock pens 11 Fuel storage 12 Fertilizer storage 13 Insecticide storage 14 Abandoned water well 15 Oil well/Gas well 16 Other (specify below)
 Direction from well? How many feet?

FROM	TO	LITHOLOGIC LOG	FROM	TO	PLUGGING INTERVALS
0	1	fill			
1	25	sandy silt w/ trace clay			
25	40	sand, clay & caliche - strong ammonia odor @ 25			
40	60	sand well-graded			
60	70	same w/ clay			
70	80	sand w/ gravel			
80	90	sandy clay, caliche & sand			
90	120	gravelly sand w/ clay & caliche			
120	130	sand w/ trace caliche			
130	133	sand w/ trace gravel			

7 CONTRACTOR'S OR LANDOWNER'S CERTIFICATION: This water well was (1) constructed, (2) reconstructed, or (3) plugged under my jurisdiction and was completed on (mo/day/year) 9/21/05 and this record is true to the best of my knowledge and belief. Kansas Water Well Contractor's Licence No 554 This Water Well Record was completed on (mo/day/yr) 11/10/06 under the business name of Woffert Pump & Well by (signature) [Signature]