


1 LOCATION OF WATER WELL: Fraction **NW 1/4 SW 1/4 NW 1/4** Section Number **2** Township Number **T 11 S** Range Number **R 32 E/W**  
 County: **Logan**

Distance and direction from nearest town or city street address of well if located within city?  
**Oakley Power Plant, Oakley, Kansas**

2 WATER WELL OWNER: **City of Oakley Oakley Power Plant**  
 RR#, St. Address, Box #: **209 Hudson** Board of Agriculture, Division of Water Resources  
 City, State, ZIP Code: **Oakley, Kansas** Application Number:

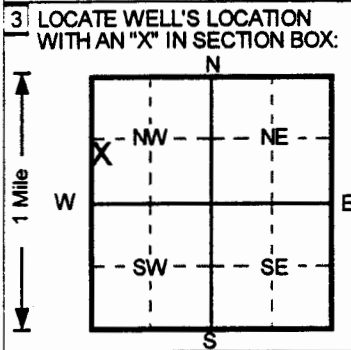

4 DEPTH OF COMPLETED WELL: **140** ft. ELEVATION: **999**  
 Depth(s) Groundwater Encountered 1. .... ft. 2. .... ft. 3. .... ft.  
 WELL'S STATIC WATER LEVEL ..... ft. below land surface measured on mo/day/yr  
 Pump test data: Well water was **NA** ft. after ..... hours pumping ..... gpm  
 Est. Yield **NA** gpm: Well water was ..... ft. after ..... hours pumping ..... gpm  
 Bore Hole Diameter **11** in. to **150** ft., and ..... in. to ..... ft.  
 WELL WATER TO BE USED AS: 5 Public water supply 8 Air conditioning 11 Injection well  
 1 Domestic 3 Feedlot 6 Oil field water supply 9 Dewatering 12 Other (Specify below)  
 2 Irrigation 4 Industrial 7 Lawn and garden only **10** Monitoring well  
 Was a chemical/bacteriological sample submitted to Department? Yes.....No.....; If yes, mo/day/yr sample was submitted  
 Water Well Disinfected? Yes No

5 TYPE OF BLANK CASING USED: 5 Wrought iron 8 Concrete tile CASING JOINTS: Glued ..... Clamped .....  
 1 Steel 3 RMP (SR) 6 Asbestos-Cement 9 Other (specify below) Welded .....  
**2** PVC 4 ABS 7 Fiberglass Threaded.   
 Blank casing diameter **4** in. to **105** ft., Dia ..... in. to ..... ft., Dia ..... in. to ..... ft.  
 Casing height above land surface **0** in., weight **Sch 40** lbs./ft. Wall thickness or gauge No. ....  
 TYPE OF SCREEN OR PERFORATION MATERIAL **7** PVC 10 Asbestos-cement  
 1 Steel 3 Stainless steel 5 Fiberglass 8 RMP (SR) 11 Other (specify) .....  
 2 Brass 4 Galvanized steel 6 Concrete tile 9 ABS 12 None used (open hole)  
 SCREEN OR PERFORATION OPENINGS ARE: 5 Gauzed wrapped 8 Saw cut 11 None (open hole)  
 1 Continuous slot **3** Mill slot 6 Wire wrapped 9 Drilled holes  
 2 Louvered shutter 4 Key punched 7 Torch cut 10 Other (specify) .....  
 SCREEN-PERFORATED INTERVALS: From **105** ft. to **140** ft., From ..... ft. to ..... ft.  
 From ..... ft. to ..... ft., From ..... ft. to ..... ft.  
 GRAVEL PACK INTERVALS: From **100** ft. to **150** ft., From ..... ft. to ..... ft.  
 From ..... ft. to ..... ft., From ..... ft. to ..... ft.

6 GROUT MATERIAL: 1 Neat cement **2** Cement grout **3** Bentonite 4 Other .....  
 Grout Intervals: From **0** ft. to **18** ft., From **18** ft. to **100** ft., From ..... ft. to ..... ft.  
 What is the nearest source of possible contamination:  
 1 Septic tank 4 Lateral lines 7 Pit privy 10 Livestock pens 14 Abandoned water well  
 2 Sewer lines 5 Cess pool 8 Sewage lagoon 11 Fuel storage 15 Oil well/Gas well  
 3 Watertight sewer lines 6 Seepage pit 9 Feedyard 12 Fertilizer storage **16** Other (specify below)  
 ... **Former Tank Basin.**  
 Direction from well? **South** How many feet? **25**

FROM	TO	LITHOLOGIC LOG	FROM	TO	PLUGGING INTERVALS
0	0.5	Sand, Gravel, Clay			
0.5	9	Clay, Dark Brown			
9	21	Clay, Light Brown			
21	35	Clay, Brown			
35	45	Sand, Brown			
45	46.5	Gravel,			
46.5	62	Clay, Brown			
62	89	Sand, Brown			
89	103	Clay, Brown			
103	132	Sand, Brown			
132	150	Sand, Brown			
					SVE6, Tag # ,
					Project Name: AG_W - Oakley Power Plant
					GeoCore # 711, #

7 CONTRACTOR'S OR LANDOWNER'S CERTIFICATION: This water well was **(1)** constructed, (2) reconstructed, or (3) plugged under my jurisdiction and was completed on (mo/day/year) **9/17/1998** and this record is true to the best of my knowledge and belief.  
 Kansas Water Well Contractor's License No. **527** This Water Well Record was completed on (mo/day/yr) **9/28/1998**  
 under the business name of **GeoCore Services, Inc.** by (signature) *[Signature]*

OFFICE USE ONLY  
T  
R  
EM  
SEC  
1/2  
1/2  
1/2