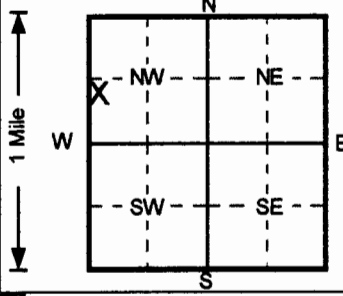


1 LOCATION OF WATER WELL: Fraction NW ¼ SW ¼ NW ¼ Section Number 2 Township Number T 11 S Range Number R 32 **EW**

Distance and direction from nearest town or city street address of well if located within city?
Oakley Power Plant, Oakley, Kansas

2 WATER WELL OWNER: City of Oakley *Oakley Power Plant*
 RR#, St. Address, Box # : 209 Hudson Board of Agriculture, Division of Water Resources
 City, State, ZIP Code : Oakley, Kansas Application Number:

3 LOCATE WELL'S LOCATION WITH AN "X" IN SECTION BOX:


4 DEPTH OF COMPLETED WELL: 120 ft. ELEVATION: 999
 Depth(s) Groundwater Encountered 1. ft. 2. ft. 3. ft.
 WELL'S STATIC WATER LEVEL ft. below land surface measured on mo/day/yr
 Pump test data: Well water was NA ft. after hours pumping gpm
 Est. Yield NA gpm: Well water was ft. after hours pumping gpm
 Bore Hole Diameter 11 in. to 125 ft., and in. to ft.
 WELL WATER TO BE USED AS: 5 Public water supply 8 Air conditioning 11 Injection well
 1 Domestic 3 Feedlot 6 Oil field water supply 9 Dewatering 12 Other (Specify below)
 2 Irrigation 4 Industrial 7 Lawn and garden only **10** Monitoring well
 Was a chemical/bacteriological sample submitted to Department? Yes.....No.....; If yes, mo/day/yr sample was submitted
 Water Well Disinfected? Yes No

5 TYPE OF BLANK CASING USED:
 1 Steel 3 RMP (SR) 5 Wrought iron 8 Concrete tile CASING JOINTS: Glued Clamped
2 PVC 4 ABS 6 Asbestos-Cement 9 Other (specify below) Welded
 7 Fiberglass Threaded.
 Blank casing diameter 4 in. to 105 ft., Dia in. to ft., Dia in. to ft.
 Casing height above land surface 0 in., weight Sch 40 lbs./ft. Wall thickness or gauge No.
 TYPE OF SCREEN OR PERFORATION MATERIAL
 1 Steel 3 Stainless steel 5 Fiberglass **7** PVC 10 Asbestos-cement
 2 Brass 4 Galvanized steel 6 Concrete tile 8 RMP (SR) 11 Other (specify)
 12 None used (open hole)
 SCREEN OR PERFORATION OPENINGS ARE:
 1 Continuous slot **3** Mill slot 5 Gauzed wrapped 8 Saw cut 11 None (open hole)
 2 Louvered shutter 4 Key punched 6 Wire wrapped 9 Drilled holes
 7 Torch cut 10 Other (specify)
 SCREEN-PERFORATED INTERVALS: From 105 ft. to 120 ft., From ft. to ft.
 From ft. to ft., From ft. to ft.
 GRAVEL PACK INTERVALS: From 100 ft. to 125 ft., From ft. to ft.
 From ft. to ft., From ft. to ft.

6 GROUT MATERIAL: 1 Neat cement **2** Cement grout **3** Bentonite 4 Other
 Grout Intervals: From 0 ft. to 87 ft., From 87 ft. to 100 ft., From ft. to ft.
 What is the nearest source of possible contamination:
 1 Septic tank 4 Lateral lines 7 Pit privy 10 Livestock pens 14 Abandoned water well
 2 Sewer lines 5 Cess pool 8 Sewage lagoon 11 Fuel storage 15 Oil well/Gas well
 3 Watertight sewer lines 6 Seepage pit 9 Feedyard 12 Fertilizer storage **16** Other (specify below)
 **Former Tank Basin.**
 Direction from well? **on top of** How many feet?

FROM	TO	LITHOLOGIC LOG	FROM	TO	PLUGGING INTERVALS
0	1	Sand, Gravel, Clay (Fill),			
1	8	Clay, Dark Brown			
8	26	Silt, Light Brown			
26	36	Clay, Light Brown			
36	45	Sand, Brown			
45	46.5	Gravel, Gray			
46.5	61	Clay, Gray			
61	70	Sand, Gray Brown			
70	78	Sand, Gray Brown			
78	87	Sand, Gray Brown			
87	101	Clay, Gray Brown			
101	118	Sand, Brown			
118	125	Sand, Brown			
					SVE4, Tag #, Flushmount
					Project Name: AG.W - Oakley Power Plant
					GeoCore # 711, #

7 CONTRACTOR'S OR LANDOWNER'S CERTIFICATION: This water well was **1** constructed, (2) reconstructed, or (3) plugged under my jurisdiction and was completed on (mo/day/year) 9/15/1998 and this record is true to the best of my knowledge and belief.
 Kansas Water Well Contractor's License No. 527 This Water Well Record was completed on (mo/day/yr) 9/28/1998
 under the business name of **GeoCore Services, Inc.** by (signature) *John Roll*

OFFICE USE ONLY
T
R
EW
SEC
%