

NW

WATER WELL RECORD Form WWC-5 KSA 82a-1212


MW-5

1 LOCATION OF WATER WELL: Fraction SW 1/4 NW 1/4 SW 1/4 Section Number 3 Township Number T 11 S Range Number R 32 EW
 County: Logan

Distance and direction from nearest town or city, street address of well if located within city?
411 West 2nd, Oakley, Kansas

2 WATER WELL OWNER: CO-AG COOP
 RR#, St. Address, Box #: 1195 Albert Street
 City, State, ZIP Code: Oakley, Kansas 67748
 Board of Agriculture, Division of Water Resources
 Application Number:

3 LOCATE WELL'S LOCATION WITH AN "X" IN SECTION BOX: 4 DEPTH OF COMPLETED WELL: 133 ft. ELEVATION: 3,048.01 ft NTOC

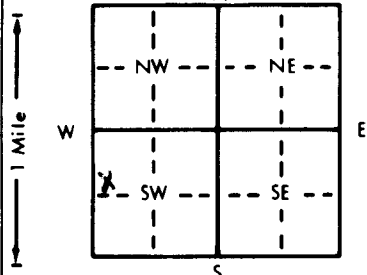

Depth(s) Groundwater Encountered 1. 108.91 ft. 2. ft. 3. ft.
 WELL'S STATIC WATER LEVEL 108.91 ft. below land surface measured on mo/day/yr 4-21-98
 Pump test data: Well water was ft. after hours pumping gpm
 Est. Yield gpm: Well water was ft. after hours pumping gpm
 Bore Hole Diameter in. to ft., and in. to ft.
 WELL WATER TO BE USED AS: 5 Public water supply 8 Air conditioning 11 Injection well
 1 Domestic 3 Feedlot 6 Oil field water supply 9 Dewatering 12 Other (Specify below)
 2 Irrigation 4 Industrial 7 Lawn and garden only 10 Monitoring well
 Was a chemical/bacteriological sample submitted to Department? Yes No X If yes, mo/day/yr sample was submitted
 Water Well Disinfected? Yes No X

5 TYPE OF BLANK CASING USED: 5 Wrought iron 8 Concrete tile CASING JOINTS: Glued Clamped
 1 Steel 3 RMP (SR) 6 Asbestos-Cement 9 Other (specify below) Welded
2 PVC 4 ABS 7 Fiberglass Threaded

Blank casing diameter 4 in. to 93 ft., Dia in. to ft., Dia in. to ft.
 Casing height above land surface in., weight lbs./ft. Wall thickness or gauge No.

TYPE OF SCREEN OR PERFORATION MATERIAL: 7 PVC 10 Asbestos-cement
 1 Steel 3 Stainless steel 5 Fiberglass 8 RMP (SR) 11 Other (specify)
 2 Brass 4 Galvanized steel 6 Concrete tile 9 ABS 12 None used (open hole)

SCREEN OR PERFORATION OPENINGS ARE: 5 Gauzed wrapped 8 Saw cut 11 None (open hole)
 1 Continuous slot 3 Mill slot 6 Wire wrapped 9 Drilled holes
 2 Louvered shutter 4 Key punched 7 Torch cut 10 Other (specify)

SCREEN-PERFORATED INTERVALS: From 93 ft. to 133 ft., From ft. to ft.
 From ft. to ft., From ft. to ft.
 GRAVEL PACK INTERVALS: From 91 ft. to 133 ft., From ft. to ft.
 From ft. to ft., From ft. to ft.

6 GROUT MATERIAL: 1 Neat cement 2 Cement grout 3 Bentonite 4 Other
 Grout Intervals: From 1 ft. to 89 ft., From ft. to ft., From ft. to ft.

What is the nearest source of possible contamination:
 1 Septic tank 4 Lateral lines 7 Pit privy 11 Fuel storage 14 Abandoned water well
 2 Sewer lines 5 Cess pool 8 Sewage lagoon 12 Fertilizer storage 15 Oil well/Gas well
 3 Watertight sewer lines 6 Seepage pit 9 Feedyard 13 Insecticide storage 16 Other (specify below)

Direction from well? How many feet?

FROM	TO	LITHOLOGIC LOG	FROM	TO	PLUGGING INTERVALS
0	5	Silt: brown, soft, moist	100	110	Sand + gravel: brown, very coarse
5	10	Silt: brown, soft, moist	110	133	Sand + gravel: brown, very coarse
10	15	Silt: brown, soft, moist			Coarse sand and gravel.
15	20	Silt: brown, soft, moist			
20	25	Clay:			
25	30	Clay: reddish brown			
30	35	Clay: reddish brown			
35	40	Sand + gravel: brown			
40	50	Sand: brown to tan dense			
50	60	Sand and gravel: brown			
60	70	Clay: gravel sand + caliche			
70	80	Clay: reddish brown, very soft			
80	90	Clay: clay, caliche, gravel			
90	100	Clay: reddish brown, dry			

7 CONTRACTOR'S OR LANDOWNER'S CERTIFICATION: This water well was (1) constructed, (2) reconstructed, or (3) plugged under my jurisdiction and was completed on (mo/day/year) 4-16-98 and this record is true to the best of my knowledge and belief. Kansas Water Well Contractor's License No. 554 This Water Well Record was completed on (mo/day/yr) 5-13-98 under the business name of Jay Woofler by (signature) Cole Wright

OFFICE USE ONLY
T
R
32
EW
SE
1/4 SW 1/4 NW 1/4 SW 1/4