


mw-6

1] LOCATION OF WATER WELL: Fraction: SW 1/4 NW 1/4 SW 1/4 Section Number: 3 Township Number: T 11 S Range Number: R 32 EW

Distance and direction from nearest town or city street address of well if located within city? 411 West 2nd, Oakley, Kansas

2] WATER WELL OWNER: CO AG COOP RR#, St. Address, Box #: 1195 Albert St, Oakley, KS 67748 Board of Agriculture, Division of Water Resources Application Number:

3] LOCATE WELL'S LOCATION WITH AN "X" IN SECTION BOX: DEPTH OF COMPLETED WELL: 131 ft. ELEVATION: 3,047.63 ft. NTC

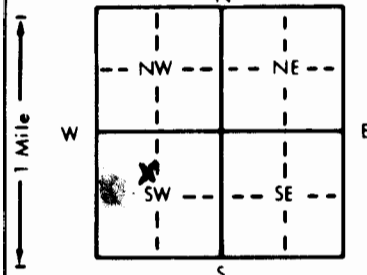

Depth(s) Groundwater Encountered: 109.11 ft. 2. ft. 3. ft. WELL'S STATIC WATER LEVEL: 109.11 ft. below land surface measured on mo/day/yr 4-21-98

Pump test data: Well water was ... ft. after ... hours pumping ... gpm

Est. Yield ... gpm: Well water was ... ft. after ... hours pumping ... gpm

Bore Hole Diameter ... in. to ... ft., and ... in. to ... ft.

WELL WATER TO BE USED AS: 5 Public water supply 8 Air conditioning 11 Injection well
1 Domestic 3 Feedlot 6 Oil field water supply 9 Dewatering 12 Other (Specify below)
2 Irrigation 4 Industrial 7 Lawn and garden only 10 Monitoring well

Was a chemical/bacteriological sample submitted to Department? Yes ... No If yes, mo/day/yr sample was submitted

Water Well Disinfected? Yes ... No

5] TYPE OF BLANK CASING USED: 1 Steel 3 RMP (SR) 5 Wrought iron 8 Concrete tile CASING JOINTS: Glued ... Clamped ...
2 PVC 4 ABS 7 Fiberglass 9 Other (specify below) Welded ... Threaded

Blank casing diameter: 4 in. to 91 ft. Dia ... in. to ... ft. Dia ... in. to ... ft.

Casing height above land surface ... in., weight ... lbs./ft. Wall thickness or gauge No. ...

TYPE OF SCREEN OR PERFORATION MATERIAL: 1 Steel 3 Stainless steel 5 Fiberglass 7 PVC 10 Asbestos-cement
2 Brass 4 Galvanized steel 6 Concrete tile 8 RMP (SR) 11 Other (specify) ...
12 None used (open hole)

SCREEN OR PERFORATION OPENINGS ARE: 1 Continuous slot 3 Mill slot 5 Gauzed wrapped 8 Saw cut 11 None (open hole)
2 Louvered shutter 4 Key punched 6 Wire wrapped 9 Drilled holes
7 Torch cut 10 Other (specify) ...

SCREEN-PERFORATED INTERVALS: From 91 ft. to 131 ft. From ... ft. to ... ft. From ... ft. to ... ft.

GRAVEL PACK INTERVALS: From 89 ft. to 131 ft. From ... ft. to ... ft. From ... ft. to ... ft.

6] GROUT MATERIAL: 1 Neat cement 2 Cement grout 3 Bentonite 4 Other
Grout Intervals: From 1 ft. to 87 ft. From ... ft. to ... ft. From ... ft. to ... ft.

What is the nearest source of possible contamination: 1 Septic tank 4 Lateral lines 7 Pit privy 10 Livestock pens 14 Abandoned water well
2 Sewer lines 5 Cess pool 8 Sewage lagoon 11 Fuel storage 15 Oil well/Gas well
3 Watertight sewer lines 6 Seepage pit 9 Feedyard 12 Fertilizer storage 16 Other (specify below)
13 Insecticide storage

Direction from well? How many feet?

FROM	TO	LITHOLOGIC LOG	FROM	TO	PLUGGING INTERVALS
0	10	Fill: concrete debris, sand			
10	15	silt: brown, dry, dense			
15	20	silt: brown, moist, sandy			
20	25	silt: brown, moist, soft			
25	30	sand: brown to tan, fine sand.			
30	35	sand and gravel: brown			
35	40	sand: reddish brown			
40	45	sand, gravel, calciche			
45	48	sand: brown to tan, dense			
48	60	sand and gravel: brown			
60	70	clay: brown to tan, very stiff			
70	75	clay: reddish brown, very stiff			
75	80	clay: reddish brown, very stiff			
80	93	clay: reddish brown, very stiff			
93	130	sand and gravel			

7] CONTRACTOR'S OR LANDOWNER'S CERTIFICATION: This water well was (1) constructed, (2) reconstructed, or (3) plugged under my jurisdiction and was completed on (mo/day/year) 4-15-98 and this record is true to the best of my knowledge and belief. Kansas Water Well Contractor's License No. 554 This Water Well Record was completed on (mo/day/yr) 05-13-98 under the business name of Jay Woolfer by (signature) Cole Smith

OFFICE USE ONLY T 11 R 32 EW SEC. 3 1/4 SW 1/4 NW 1/4 SW