


1 LOCATION OF WATER WELL: County: Kogon Fraction: NW 1/4 NW 1/4 NE 1/4 Section Number: 8 Township Number: T 11 S Range Number: R 32 E (W)  
 Distance and direction from nearest town or city street address of well if located within city?

2 WATER WELL OWNER: Herman Schippers  
 RR#, St. Address, Box #: 418 S. Smokyhill Ave  
 City, State, ZIP Code: Oakley, KS 67748  
 Board of Agriculture, Division of Water Resources  
 Application Number: 15,251

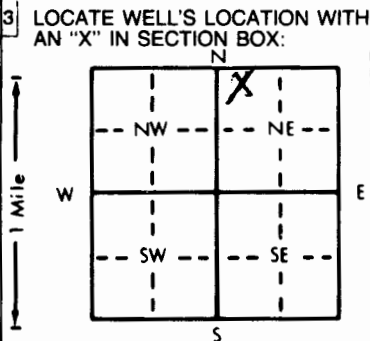

4 DEPTH OF COMPLETED WELL: 227 ft. ELEVATION: \_\_\_\_\_  
 Depth(s) Groundwater Encountered 1. \_\_\_\_\_ ft. 2. \_\_\_\_\_ ft. 3. \_\_\_\_\_ ft.  
 WELL'S STATIC WATER LEVEL: 148 ft. below land surface measured on mo/day/yr  
 Pump test data: Well water was \_\_\_\_\_ ft. after \_\_\_\_\_ hours pumping \_\_\_\_\_ gpm  
 Est. Yield \_\_\_\_\_ gpm: Well water was \_\_\_\_\_ ft. after \_\_\_\_\_ hours pumping \_\_\_\_\_ gpm  
 Bore Hole Diameter: 16 in. to 227 ft. and \_\_\_\_\_ in. to \_\_\_\_\_ ft.  
 WELL WATER TO BE USED AS:  
 5 Public water supply 8 Air conditioning 11 Injection well  
 1 Domestic 3 Feedlot 6 Oil field water supply 9 Dewatering 12 Other (Specify below)  
 2 Irrigation 4 Industrial 7 Lawn and garden only 10 Monitoring well  
 Was a chemical/bacteriological sample submitted to Department? Yes \_\_\_\_\_ No X; If yes, mo/day/yr sample was submitted \_\_\_\_\_  
 Water Well Disinfected? Yes \_\_\_\_\_ No X

5 TYPE OF BLANK CASING USED:  
 1 Steel 3 RMP (SR) 5 Wrought iron 8 Concrete tile CASING JOINTS: Glued X Clamped \_\_\_\_\_  
 2 PVC 4 ABS 6 Asbestos-Cement 9 Other (specify below) Welded \_\_\_\_\_  
 7 Fiberglass Threaded \_\_\_\_\_  
 Blank casing diameter: 16 in. to \_\_\_\_\_ ft., Dia: 147 in. to \_\_\_\_\_ ft., Dia: \_\_\_\_\_ in. to \_\_\_\_\_ ft.  
 Casing height above land surface: 24 in., weight: 16.15 lbs./ft. Wall thickness or gauge No. .500  
 TYPE OF SCREEN OR PERFORATION MATERIAL:  
 1 Steel 3 Stainless steel 5 Fiberglass 8 RMP (SR) 10 Asbestos-cement  
 2 Brass 4 Galvanized steel 6 Concrete tile 9 ABS 11 Other (specify) \_\_\_\_\_  
 12 None used (open hole)  
 SCREEN OR PERFORATION OPENINGS ARE:  
 1 Continuous slot 3 Mill slot 5 Gauzed wrapped 8 Saw cut 11 None (open hole)  
 2 Louvered shutter 4 Key punched 6 Wire wrapped 9 Drilled holes  
 7 Torch cut 10 Other (specify) \_\_\_\_\_  
 SCREEN-PERFORATED INTERVALS: From \_\_\_\_\_ ft. to 227 ft., From \_\_\_\_\_ ft. to \_\_\_\_\_ ft.  
 GRAVEL PACK INTERVALS: From \_\_\_\_\_ ft. to 20 ft., From 20 ft. to 227 ft., From \_\_\_\_\_ ft. to \_\_\_\_\_ ft.

6 GROUT MATERIAL: 1 Neat cement 2 Cement grout 3 Bentonite 4 Other \_\_\_\_\_  
 Grout Intervals: From \_\_\_\_\_ ft. to 20 ft., From \_\_\_\_\_ ft. to \_\_\_\_\_ ft., From \_\_\_\_\_ ft. to \_\_\_\_\_ ft.  
 What is the nearest source of possible contamination:  
 1 Septic tank 4 Lateral lines 7 Pit privy 10 Livestock pens 14 Abandoned water well  
 2 Sewer lines 5 Cess pool 8 Sewage lagoon 11 Fuel storage 15 Oil well/Gas well  
 3 Watertight sewer lines 6 Seepage pit 9 Feedyard 12 Fertilizer storage 16 Other (specify below)  
 13 Insecticide storage None  
 Direction from well? \_\_\_\_\_ How many feet? \_\_\_\_\_

FROM	TO	LITHOLOGIC LOG	FROM	TO	PLUGGING INTERVALS
0	2	Surface	157	164	med sand & gravel w/clay lns
2	17	Loess	164	178	med sand & gravel
17	36	Sandy Clay w/med sand strks	178	180	med sand w/clay strks
36	45	Cem. sand & Caliche w/sand	180	193	sticky clay
45	56	Sandy Clay & Caliche	193	207.5	Clay, Caliche & med sand
56	62	Sandy Clay & Caliche w/sand strks	207.5	217	Med Sand & Gravel w/Fine Clay lns
62	73	med Sand & Gravel w/Rocks	217	227	Ochre & Black Stale
73	80	Caliche, Cem. sand w/clay			
80	91	Semi-light fine sand & clay			
91	111	med sand & gravel w/clay lns			
111	120	med sand w/clay strks			
120	143	med sand & gravel			
143	143.5	Cem. sand			
143.5	154	med sand & gravel			
154	157	sandy Clay w/s. sand			

7 CONTRACTOR'S OR LANDOWNER'S CERTIFICATION: This water well was (1) constructed, (2) reconstructed, or (3) plugged under my jurisdiction and was completed on (mo/day/year) 5-8-98 and this record is true to the best of my knowledge and belief. Kansas  
 Water Well Contractor's License No. 554 This Water Well Record was completed on (mo/day/yr) 6-1-98  
 under the business name of Wagner Pumps Well, Inc by (signature) Jay G. Wagner

OFFICE USE ONLY  
T  
R  
EW  
SEC.  
1/4  
1/4  
1/4