USE TYPEWRITER OR BALL POINT PEN-PRESS FIRMLY, PRINT CLEARLY.

T R EW sec 1/4 1/4 1/4 No.

WATER WELL RECORD
KSA 82a-1201-1215

D4B

Kansas State Dept. Of Health
(Water Well Contractors)
Forbes-Bldg. 740
Topeka, Kansas 66620

1 Location of well:	County	Township name	Fraction	Section number	Town number	Range number
	Logan	Oakley	NW NE SE	14	11	32

Distance and direction from nearest town or city: 2S,13/4E,¼N of Oakley, Kansas
Street address of well location if in city:

3 Owner of well: Duard Goble
Address: Oakley, Kansas 67748

Locate with "X" in section below:

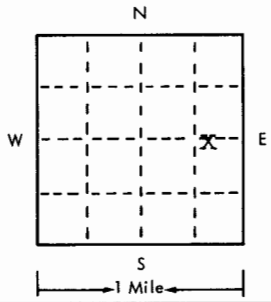

Sketch map:

4 Well depth: 150 ft. Date of completion 10/9
Well diameter 8 in.

5 ☐ Cable tool ☒ Rotary ☐ Driven ☐ Dug
☐ Hollow rod ☐ Jetted ☐ Bored ☐ Reverse rotary

6 Use: ☒ Domestic ☐ Public supply ☐ Industry
☐ Irrigation ☐ Air conditioning ☐ Commercial
☐ Test well ☐

7 Casing: Material RMP Height: above/below
Threaded ☐ Welded ☒ Surface 15 inch
Diam. 5 in. to 150 ft. depth Weight ___ lbs./ft.
___ in. to ___ ft. depth Drive shoe? ☐ Yes ☒ No

2 Type and color of material	From	To
Top Soil	0	35
Sand Clay	35	79
Sand Rock	79	92
Sand	92	107
Sand and Clay Strips	107	150
Shale	150	
(use a second sheet if needed)		

8 Screen:
Manufacturer J & L
Type RMP Dia. 5
Slot/gauze .032 Length 2.5"
Set between 130 ft. and 150 ft.
Fittings:
Gravel pack ☒ Yes ☐ No Size range of material 1/8"

9 Static water level:
104 ft. below land surface Date 10/9

10 Pumping level below land surfaces:
___ ft. after NA hrs. pumping ___ g.p.m.
___ ft. after ___ hrs. pumping ___ g.p.m.
Estimated maximum yield ___ g.p.m.

11 Water sample submitted:
☐ Yes ☒ No Date ___

12 Well head completion:
☒ Pitless adapter ☐ Inches above grade
NO

13 Well grouted? ☒ Yes ☐ No
☒ Neat cement ☐ Bentonite ☐
Depth: From 18 ft. to 4 ft.

14 Nearest source of possible contamination:
ft. 1000 Direction SW Type Ponds
Well disinfected upon completion? ☒ Yes ☐ No

15 Pump: ☒ Not installed
Manufacturer's name
Model number HP Volts
Length of drop pipe ft. capacity g.m.p.
Type:
☐ Submersible ☐ Turbine
☐ Jet ☐ Reciprocating
☐ Certrifugal ☐ Other

16 Remarks: elevation 3030 (TOPO)

3030
104
2926

Topography:
☐ Hill
☐ Slope
☒ Upland
☐ Valley

17 Water well contractor's certification:
This well was drilled under my jurisdiction and this report is true to the best of my knowledge and belief.
Business name Bartell Drilling 139 License No.
Address Winona, Kansas 67764
Signed Joyce Bartell Date 1-5-76
Authorized representative

11 32 W 14 NW NE SE

Forward the white, blue and pink copies to the Kansas State Dept. Of Health.

Form WWC-5

677-H