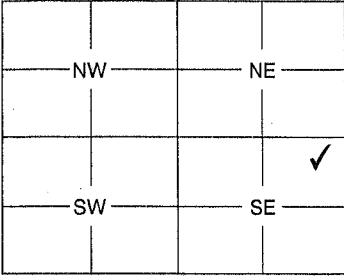


1	LOCATION OF WATER WELL:	Fraction	Section Number	Township Number	Range Number
County: <b>Logan</b>		<b>NE 1/4 NE 1/4 SE 1/4</b>	<b>3</b>	<b>11</b>	<b>32</b> <span style="border: 1px solid black; padding: 0 2px;">E/W</span>

Distance and direction from nearest town or city street address of well if located within city?

319 E. Front Street - Oakley, Kansas

2	WATER WELL OWNER: <b>Great Western Tire</b>	
RR #, St. Address, Box #: <b>319 E. Front St.</b>		Board of Agriculture, Division of Water Resources Application Number: <b>IW-4</b>
City, State, ZIP Code: <b>Oakley, KS 67748</b>		

3	MARK WELL'S LOCATION WITH AN "X" IN SECTION BOX:	4	DEPTH OF WELL <b>135.8</b> ft. WELL'S STATIC WATER LEVEL <b>121.0</b> ft. WELL WAS USED AS: <table border="0"><tr><td>1 Domestic</td><td>5 Public Water Supply</td><td>9 Dewatering</td></tr><tr><td>2 Irrigation</td><td>6 Oil Field Water Supply</td><td><span style="border: 1px solid black; padding: 0 2px;">10</span> Monitoring Well</td></tr><tr><td>3 Feedlot</td><td>7 Domestic (Lawn &amp; Garden)</td><td>11 Injection Well</td></tr><tr><td>4 Industrial</td><td>8 Air Conditioning</td><td>12 Other .....</td></tr>
<div style="text-align: center;">N W      E SW      SE S</div> 		Was a chemical / bacteriological sample submitted to Department? Yes ..... No <span style="border: 1px solid black; padding: 0 2px;">✓</span> ..... If yes, mo/day/yr sample was submitted .....													
		Water Well Disinfected: Yes ..... No <span style="border: 1px solid black; padding: 0 2px;">✓</span> .....													

5	TYPE OF BLANK CASING USED:										
<table border="0"><tr><td>1 Steel</td><td>3 RMP (SR)</td><td>5 Wrought</td><td>7 Fiberglass</td><td>9 Other (Specify below)</td></tr><tr><td><span style="border: 1px solid black; padding: 0 2px;">2</span> PVC</td><td>4 ABS</td><td>6 Asbestos-Cement</td><td>8 Concrete Tile</td><td></td></tr>
Blank casing diameter ..... in. Was casing pulled? Yes <span style="border: 1px solid black; padding: 0 2px;">✓</span> ..... No ..... If yes, how much <b>3'</b> .....											
Casing height above or below land surface <b>40</b> in.											

6	GROUT PLUG MATERIAL:	1 Neat cement	2 Cement grout	<span style="border: 1px solid black; padding: 0 2px;">3</span> Bentonite	4 Other .....																				
Grout Plug Intervals:		From <b>3</b> ft. to <b>121</b> ft.,	From ..... ft. to ..... ft.,	From ..... ft. to ..... ft.																					
What is the nearest source of possible contamination:																									
<table border="0"><tr><td>1 Septic tank</td><td>6 Seepage pit</td><td><span style="border: 1px solid black; padding: 0 2px;">11</span> Fuel storage</td><td>16 Other (specify below)</td></tr><tr><td>2 Sewer lines</td><td>7 Pit privy</td><td>12 Fertilizer storage</td><td></td></tr><tr><td>3 Watertight sewer lines</td><td>8 Sewage lagoon</td><td>13 Insecticide storage</td><td></td></tr><tr><td>4 Lateral lines</td><td>9 Feedyard</td><td>14 Abandoned water well</td><td></td></tr><tr><td>5 Cess pool</td><td>10 Livestock pens</td><td>15 Oil well/Gas well</td><td></td></tr>
Direction from well? ..... How many feet? .....																									

FROM	TO	PLUGGING MATERIALS
0	3	Soil
3	121	Bentonite
121	135.8	Sand

7	CONTRACTOR'S OF LANDOWNER'S CERTIFICATION: This water well was plugged under my jurisdiction and was completed on (mo/day/year) <b>06-16-2011</b> and this record is true to the best of my knowledge and belief. Kansas Water Well Contractor's License No. <b>06-22-2011</b> under the business name of <b>MILCO Environmental Services, Inc.</b> This Water Well Record was completed on (mo/day/year) <b>06-22-2011</b> by (signature) <i>[Signature]</i>
---	--

INSTRUCTIONS: Use typewriter or ball point pen. Please press firmly and print clearly. Please fill in blanks, underline or circle the correct answers. Send top three copies to Kansas Department of Health and Environment, Bureau of Water, Geology Section, 1000 SW Jackson St., Ste. 420, Topeka, Kansas 66612-1367. Telephone: 785/296-5522. Send one to Water Well Owner and retain one for your records.