

**WATER WELL PLUGGING RECORD**

Form WWC-5P

KSA 82a-1212

ID No.


SVE-5

<b>1</b> LOCATION OF WATER WELL:	Fraction	Section Number	Township Number	Range Number
County: Logan	NW ¼ SW ¼ NW ¼	2	11S	32W

Distance and direction from nearest town or city street address of well if located within city?

**2** WATER WELL OWNER: Oakley Power Plant  
 RR#, St. Address, Box # 400 Price Avenue  
 City, State, ZIP Code : Oakley, KS 67748  
 Board of Agriculture, Division of Water Resources  
 Application Number:

**3** MARK WELL'S LOCATION WITH AN "X" IN SECTION BOX:

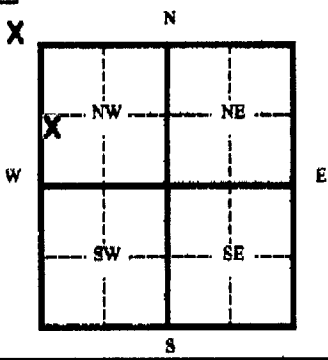

**4** DEPTH OF WELL 130 ft.

WELL'S STATIC WATER LEVEL \_\_\_\_\_ ft.

WELL WAS USED AS:

- |              |                              |                    |
|--------------|------------------------------|--------------------|
| 1 Domestic   | 5 Public Water Supply        | 9 Dewatering       |
| 2 Irrigation | 6 Oil Field Water Supply     | 10 Monitoring Well |
| 3 Feedlot    | 7 Lawn and Garden (domestic) | 11 Injection Well  |
| 4 Industrial | 8 Air Conditioning           | 12 Other _____     |

Was a chemical/bacteriological sample submitted to Department? Yes \_\_\_\_\_ No \_\_\_\_\_

If yes, mo/day/yr sample was submitted \_\_\_\_\_

Water Well Disinfected: Yes \_\_\_\_\_ No \_\_\_\_\_

**5** TYPE OF BLANK CASING USED:

1 Steel	3 RMP (SR)	5 Wrought	7 Fiberglass	9 Other (specify below)
2 PVC	4 ABC	6 Asbestos-Cement	8 Concrete Tile	

Blank casing diameter 4 in. Was casing pulled? Yes  No \_\_\_\_\_ If yes, how much 3 feet

Casing height above or below land surface \_\_\_\_\_ in.

**6** GROUT PLUG MATERIAL: 1 Neat cement 2 Cement grout 3 Bentonite 4 Other \_\_\_\_\_

Grout Plug Intervals From \_\_\_\_\_ ft. to \_\_\_\_\_ ft. From \_\_\_\_\_ ft. to \_\_\_\_\_ ft.

What is the nearest source of possible contamination:

- |                          |                   |                         |                          |
|--------------------------|-------------------|-------------------------|--------------------------|
| 1 Septic tank            | 6 Seepage pit     | 11 Fuel storage         | 16 Other (specify below) |
| 2 Sewer lines            | 7 Pit privy       | 12 Fertilizer storage   |                          |
| 3 Watertight sewer lines | 8 Sewage lagoon   | 13 Insecticide storage  |                          |
| 4 Lateral lines          | 9 Feedyard        | 14 Abandoned water well |                          |
| 5 Cess Pool              | 10 Livestock pens | 15 Oil well/ Gas well   |                          |

Direction from well? \_\_\_\_\_ How many feet? \_\_\_\_\_

FROM	TO	CODE	PLUGGING MATERIALS
0	130		Bentonite chips

**7** CONTRACTOR'S OR LANDOWNER'S CERTIFICATION: This water well was plugged under my jurisdiction and was completed on (mo/day/yr) 11/4/15 and this record is true to the best of my knowledge and belief. Kansas Water Well Contractor's License No. 12/11/15 This Water Well Record was completed on (mo/day/yr) \_\_\_\_\_ under the business name of Bluestem Environmental Engineering, Inc. by (signature) *Nick Holt*

INSTRUCTIONS: Please fill in blanks and circle the correct answers. Send three copies to Kansas Department of Health and Environment, Bureau of Water, 1000 S W Jackson St., Ste. 420, Topeka, Kansas 66620-0001. Telephone: 785-298-3565. Send one to Water Well Owner and retain one for your records.