

CORRECTED




mwl

WATER WELL PLUGGING RECORD Form WWC-51 KSA 82a-1212 ID NO.

1 LOCATION OF WATER WELL: Fraction Section Number Township Number Range Number
County: Logan SE 1/4 NE 1/4 NW 1/4 NE 1/4 3 11 T S 32

Street/Rural Address of Well Location; if unknown, distance & direction from nearest town or intersection: If at owner's address, check here 709 Center, Oakley, Kansas
Global Positioning Systems (GPS) information: Latitude: 39.1323813 Longitude: 100.8545218 Elevation: 3058 Datum: WGS84, NAD83, NAD27 Collection Method:

2 WATER WELL OWNER: Coranco Great Plains, Inc. RR#, St. Address, Box #: 141 W 10th Avenue City, State ZIP Code: Wahoo NE 68066
GPS unit (Make/Model): Digital Map/Photo, Topographic Map, Land Survey Est. Accuracy: < 3 m, 3-5 m, 5-15 m, > 15 m

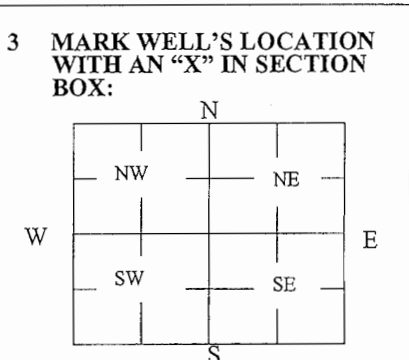

3 MARK WELL'S LOCATION WITH AN 'X' IN SECTION BOX:
4 DEPTH OF WELL 135.12 ft. WELL'S STATIC WATER LEVEL 129.39 ft. WELL WAS USED AS: Domestic, Irrigation, Feedlot, Industrial, Public Water Supply, Oil Field Water Supply, Domestic (Lawn & Garden), Air Conditioning, Dewatering, Monitoring, Injection Well, Other. Was a chemical/bacteriological sample submitted to Department? Yes No

5 TYPE OF BLANK CASING USED: Steel, PVC, RMP (SR), ABS, Wrought, Asbestos-Cement, Fiberglass, Concrete Tile, Other (Specify below)
Blank casing diameter 4 in. Was casing pulled? Yes No If yes, how much 3' Casing height above or below land surface 36 in.

6 GROUT PLUG MATERIAL: Neat cement, Cement grout, Bentonite, Other
Grout Plug Intervals: From 3 ft. to 135.12 ft., From ft. to ft., From ft. to ft.
What is the nearest source of possible contamination: Septic tank, Sewer lines, Watertight sewer lines, Lateral lines, Cess pool, Seepage pit, Pit privy, Sewage lagoon, Feedyard, Livestock pens, Fuel storage, Fertilizer storage, Insecticide storage, Abandoned water well, Oil well/Gas well, Other (specify below) Direction from well? south How many feet? 0

Table with columns: FROM, TO, PLUGGING MATERIALS. Row 1: 0, 3, Native Soil. Row 2: 3, 135.12, Bentonite.

7 CONTRACTOR'S OR LANDOWNER'S CERTIFICATION: This water well was plugged under my jurisdiction and was completed on (mo/day/year) 7/25/2017 and this record is true to the best of my knowledge and belief. Kansas Water Well Contractor's License No. 594. This Water Well Record was completed on (mo/day/year) 7/25/2017 under the business name of Coranco Great Plains, Inc by (signature)

Send one white copy to Kansas Department of Health & Environment, Geology Section, 1000 SW Jackson Street, Ste. 420, Topeka, KS 66612-1367. Send one copy to WATER WELL OWNER and our records. Visit us at http://www.kdheks.gov/waterwell/index.html Telephone 785-296-5524.