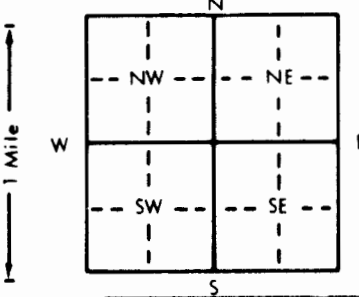


<b>1 LOCATION OF WATER WELL:</b> County: <u>Logan</u>		Fraction <u>SE</u> $\frac{1}{4}$ <u>SW</u> $\frac{1}{4}$ <u>NE</u> $\frac{1}{4}$		Section Number <u>3</u>	Township Number <u>T 11 S</u>	Range Number <u>R 32 E</u>	
Distance and direction from nearest town or city street address of well if located within city? <u>203 Center St., Oakley, Ks. 67748</u>	
<b>2 WATER WELL OWNER:</b> <u>Bryan's Service</u> RR#, St. Address, Box # : <u>203 Center</u> City, State, ZIP Code : <u>Oakley, Ks. 67748</u>	
				MW# <u>6</u> SB # <u>9</u>	Board of Agriculture, Division of Water Resources Application Number:	
<b>3 LOCATE WELL'S LOCATION WITH AN "X" IN SECTION BOX:</b>		<b>4 DEPTH OF COMPLETED WELL:</b> <u>135</u> ft. <b>ELEVATION:</b> _____ ft.	
<div style="text-align: center;">N W      E S</div> 		Depth(s) Groundwater Encountered <u>1</u> ft. <u>2</u> ft. <u>3</u> ft.	
		WELL'S STATIC WATER LEVEL <u>115.54</u> ft. below land surface measured on mo/day/yr	
		Pump test data: Well water was _____ ft. after _____ hours pumping _____ gpm	
		Est. Yield _____ gpm: Well water was _____ ft. after _____ hours pumping _____ gpm	
		Bore Hole Diameter <u>8</u> in. to <u>135</u> ft. and _____ in. to _____ ft.	
TYPE OF BLANK CASING USED:		CASING JOINTS: Glued _____ Clamped _____	
1 Steel		3 RMP (SR)		6 Asbestos-Cement		9 Other (specify below)	
2 PVC		4 ABS		7 Fiberglass		10 Asbestos-cement	
Blank casing diameter <u>4</u> in. to <u>105</u> ft. Dia _____ in. to _____ ft. Dia _____ in. to _____ ft.		Welded _____	
Casing height above land surface <u>0</u> in., weight <u>2.071</u> lbs./ft. Wall thickness or gauge No. <u>.237</u>		Threaded <u>X</u>	
TYPE OF SCREEN OR PERFORATION MATERIAL:		7 PVC	
1 Steel		3 Stainless steel		5 Fiberglass		8 RMP (SR)	
2 Brass		4 Galvanized steel		6 Concrete tile		9 ABS	
SCREEN OR PERFORATION OPENINGS ARE:		10 Asbestos-cement	
1 Continuous slot		3 Mill slot		5 Gauzed wrapped		8 Saw cut	
2 Louvered shutter		4 Key punched		6 Wire wrapped		9 Drilled holes	
SCREEN-PERFORATED INTERVALS: From <u>105</u> ft. to <u>135</u> ft. From _____ ft. to _____ ft. From _____ ft. to _____ ft.		7 Torch cut	
GRAVEL PACK INTERVALS: From <u>103</u> ft. to <u>135</u> ft. From _____ ft. to _____ ft. From _____ ft. to _____ ft.		10 Other (specify) _____	
FROM _____ ft. to _____ ft. FROM _____ ft. to _____ ft. FROM _____ ft. to _____ ft.		11 None (open hole)	
<b>6 GROUT MATERIAL:</b> 1 Neat cement 2 <u>Cement grout</u> 3 Bentonite 4 Other _____	
Grout Intervals: From <u>0</u> ft. to <u>95</u> ft. From <u>95</u> ft. to <u>103</u> ft. From _____ ft. to _____ ft.	
What is the nearest source of possible contamination:	
1 Septic tank		4 Lateral lines		7 Pit privy		10 Livestock pens	
2 Sewer lines		5 Cess pool		8 Sewage lagoon		11 Fuel storage	
3 Watertight sewer lines		6 Seepage pit		9 Feedyard		12 Fertilizer storage	
						13 Insecticide storage	
Direction from well?						14 Abandoned water well	
						15 Oil well/Gas well	
						16 Other (specify below)	
						Removed Fuel Storage	
						How many feet?	
<table border="1" style="width:100%; border-collapse: collapse;"><thead><tr><th>FROM</th><th>TO</th><th>LITHOLOGIC LOG</th><th>FROM</th><th>TO</th><th>PLUGGING INTERVALS</th></tr></thead><tbody><tr><td>0</td><td>.8</td><td>Cement</td><td>124</td><td>130</td><td>Tight Med. Sand</td></tr><tr><td>.8</td><td>18</td><td>Loess</td><td>130</td><td>135</td><td>Med. Sand &amp; Gravel</td></tr><tr><td>18</td><td>30</td><td>Sandy Clay Caliche &amp; Sand Mix</td><td></td><td></td><td></td></tr><tr><td>30</td><td>35</td><td>Sandy Clay &amp; Caliche</td><td></td><td></td><td></td></tr><tr><td>35</td><td>50</td><td>Fine Sand w/Some Clay &amp; Caliche</td><td></td><td></td><td></td></tr><tr><td>50</td><td>57</td><td>Cemented Sand w/Sand Strks.</td><td></td><td></td><td></td></tr><tr><td>57</td><td>60</td><td>Med. Sand &amp; Gravelw/fine Cemented Sand strks.</td><td></td><td></td><td></td></tr><tr><td>60</td><td>75</td><td>Sandy Clay &amp; Caliche</td><td></td><td></td><td></td></tr><tr><td>75</td><td>80</td><td>Sandy Clay, Caliche&amp; Sand Str.</td><td></td><td></td><td></td></tr><tr><td>80</td><td>86</td><td>Med. Sand &amp; Gravel</td><td></td><td></td><td></td></tr><tr><td>86</td><td>90</td><td>Sandy Clay w/Sand &amp; Gravel</td><td></td><td></td><td></td></tr><tr><td>90</td><td>100</td><td>Fine to Med. Sand w/Some Clay</td><td></td><td></td><td></td></tr><tr><td>100</td><td>120</td><td>Med. Sand &amp; Gravel w/Clay</td><td></td><td></td><td></td></tr><tr><td>120</td><td>124</td><td>Sandy Clay w/Sand Strks.</td><td></td><td></td><td></td></tr>
<b>7 CONTRACTOR'S OR LANDOWNER'S CERTIFICATION:</b> This water well was (1) constructed, (2) reconstructed, or (3) plugged under my jurisdiction and was completed on (mo/day/year) <u>5-23-94</u> and this record is true to the best of my knowledge and belief. Kansas Water Well Contractor's License No. <u>554</u> This Water Well Record was completed on (mo/day/yr) <u>9-15-94</u> under the business name of <u>Woofter Pump &amp; Well, Inc.</u> by (signature) <u>[Signature]</u>	
INSTRUCTIONS: Use typewriter or ball point pen. PLEASE PRESS FIRMLY and PRINT clearly. Please fill in blanks, underline or circle the correct answers. Send top three copies to Kansas Department of Health and Environment, Bureau of Water, Topeka, Kansas 66620-0001. Telephone: 913-296-5545. Send one to WATER WELL OWNER and retain one for your records.	

OFFICE USE ONLY

T

R

E/W

SEC.

1/4

1/4

1/4