USE TYPEWRITER OR BALL POINT PEN-PRESS FIRMLY, PRINT CLEARLY.

WATER WELL RECORD
KSA 82a-1201-1215

Kansas Department of Health and Environment-Division of Environment
(Water well Contractors)
Topeka, Kansas 66620

1. Location of well:	County	Fraction	Section number	Township number	Range number
	Logan	SW 1/4 SW 1/4 SW 1/4	8	T 11 S	R 33 E/W

2. Distance and direction from nearest town or city:
Street address of well location if in city: In Monument

3. Owner of well: William Robinson
R.R. or street: Box 648
City, state, zip code: Monument, Ks 67747

4. Locate with "X" in section below:

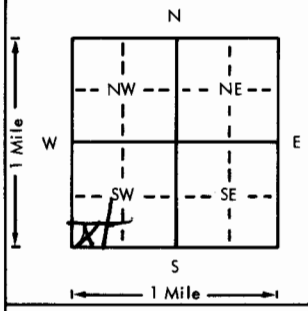

Sketch map:

6. Bore hole dia. 9 in. Completion date 5-81
Well depth 240 ft.

7. __ Cable tool X Rotary __ Driven __ Dug
__ Hollow rod __ Jetted __ Bored __ Reverse rotary

8. Use: X Domestic __ Public supply __ Industry
__ Irrigation __ Air conditioning __ Stock
__ Lawn __ Oil field water __ Other

9. Casing: Material _____ Height: Above or below
Threaded ____ Welded ____ Surface 12 in.
RMP ____ PVC X Weight 200 lbs./ft.
Dia. 0 in. to 240 ft. depth Wall Thickness: inches or
Dia. ____ in. to ____ ft. depth gage No. 214

5. Type and color of material	From	To
Top Soil	0	27
Sandy Clay	27	90
M Gravel	90	103
Sandy Clay	103	109
M. Gravel	109	125
Sandy Clay	125	155
F. Sand	155	158
Sandy Clay	158	233
M Gravel	233	238
Ochre	238	240
(Use a second sheet if needed)		

10. Screen: Manufacturer's name Jess Powell
Type PVC Dia. 5"
Slot/gauze 110-48 Length
Set between 228 ft. and 240 ft.
ft. and ft.
Gravel pack? X Size range of material 44-3/110

11. Static water level: mo./day/yr.
155 ft. below land surface Date 5-81

12. Pumping level below land surfaces:
____ ft. after ____ hrs. pumping ____ g.p.m.
____ ft. after ____ hrs. pumping ____ g.p.m.
Estimated maximum yield 10 g.p.m.

13. Water sample submitted: mo./day/yr.
__ Yes X No Date

14. Well head completion:
X Pitless adapter 12 Inches above grade

15. Well grouted? X
With: X Neat cement ____ Bentonite ____ Concrete
Depth: From 4 ft. to 14 ft.

16. Nearest source of possible contamination:
ft. 150 Direction S Type Sewer
Well disinfected upon completion? X Yes __ No

17. Pump: ____ Not installed
Manufacturer's name Goulds
Model number 3/4 105 HP 3/4 Volts 230
Length of drop pipe 280 ft. capacity 10 g.p.m.
Type:
X Submersible ____ Turbine
____ Jet ____ Reciprocating
____ Centrifugal ____ Other

18. Elevation:
Topography:
____ Hill
____ Slope
X Upland
____ Valley

19. Remarks:

20. Water well contractor's certification:
This well was drilled under my jurisdiction and this report is true to the best of my knowledge and belief.
B & B Drilling 376
Business name License No.
Address Grinnell, Ks
Signed Joseph Burns Date 5-81
Authorized representative

T 11 R 33 E/W Sec 8 1/4 1/4 1/4 1/4 SW SW SW

Forward the white, blue and pink copies to the Department of Health and Environment

Form WWC-5

MI-1023