

**WATER WELL PLUGGING RECORD Form WWC-5P**

KSA 82a-1212

ID NO.

MW#1


**1 LOCATION OF WATER WELL:** County: LOGAN Fraction: 1/4 SW 1/4 SW 1/4 SW 1/4 Section Number: 14 Township Number: T 11 S Range Number: 33  E  W

Street/Rural Address of Well Location; if unknown, distance & direction from nearest town or intersection: If at owner's address, check here  NEC CEDAR CREST & CR380 OAKLEY, KANSAS

**Global Positioning Systems (GPS) Information:**  
 Latitude: 39.09029 (in decimal degrees)  
 Longitude: -100.96062 (in decimal degrees)  
 Elevation: \_\_\_\_\_  
 Datum:  WGS84,  NAD83,  NAD27  
 Collection Method: \_\_\_\_\_

**2 WATER WELL OWNER:** PLAINS ALL AMERICAN  
 RR#, St. Address, Box #: PO BOX 4648  
 City, State ZIP Code: HOUSTON, TX 77210

GPS unit (Make/Model: \_\_\_\_\_)  
 Digital Map/Photo,  Topographic Map,  Land Survey  
 Est. Accuracy:  <3 m,  3-5 m,  5-15 m,  >15 m

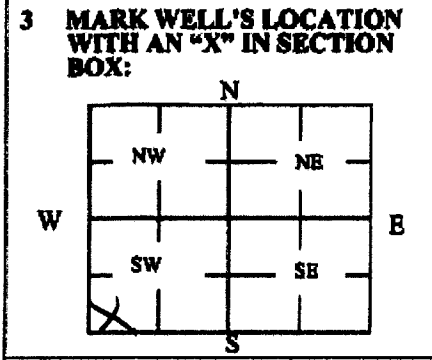

**4 DEPTH OF WELL** 153 ft.  
**WELL'S STATIC WATER LEVEL** 145 ft.  
**WELL WAS USED AS:**  
 Domestic Irrigation Feedlot Industrial  
 Public Water Supply Oil Field Water Supply Domestic (Lawn & Garden) Air Conditioning  
 Dewatering Monitoring Injection Well Other \_\_\_\_\_  
 Was a chemical/bacteriological sample submitted to Department? Yes  No

**5 TYPE OF BLANK CASING USED:**  
 Steel PVC  RMP (SR) ABS  Wrought Asbestos-Cement  Fiberglass Concrete Tile  Other (Specify below) \_\_\_\_\_  
 Blank casing diameter 4.5 in. Was casing pulled? Yes  No  If yes, how much 3 FT (below grade)  
 Casing height above or below land surface 36 in.

**6 GROUT PLUG MATERIAL:**  Neat cement  Cement grout  Bentonite  Other \_\_\_\_\_  
 Grout Plug Intervals: From 0 ft. to 153 ft., From \_\_\_\_\_ ft. to \_\_\_\_\_ ft., From \_\_\_\_\_ ft. to \_\_\_\_\_ ft.  
 What is the nearest source of possible contamination:  
 Septic tank  Sewer lines  Watertight sewer lines  Lateral lines  Cess pool  
 Seepage pit  Pit privy  Sewage lagoon  Feedyard  Livestock pens  
 Fuel storage  Fertilizer storage  Insecticide storage  Abandoned water well  Oil well/Gas well  
 Other (specify below) \_\_\_\_\_  
 Direction from well? \_\_\_\_\_  
 How many feet? \_\_\_\_\_

FROM	TO	PLUGGING MATERIALS	FROM	TO	PLUGGING MATERIALS
10	153	BENTONITE			
0	10	SAND			

**7 CONTRACTOR'S OR LANDOWNER'S CERTIFICATION:** This water well was plugged under my jurisdiction and was completed on (mo/day/year) 12/16/2013 and this record is true to the best of my knowledge and belief. Kansas Water Well Contractor's License No. 410. This Water Well Record was completed on (mo/day/year) 12/18/2013 under the business name of TERRACON CONSULTANTS INC. by (signature) \_\_\_\_\_

**INSTRUCTIONS:** Use typewriter or ballpoint pen. Please press firmly and print clearly. Please fill in blanks, underline or circle the correct answers. Send top three copies to Kansas Department of Health and Environment, Bureau of Water, Geology Section, 1000 SW Jackson St., Ste. 420, Topeka, Kansas 66612-1367. Telephone: 785/296-5524. Send one to Water Well Owner and retain one for your records. Visit us at <http://www.kdheks.gov/waterwell/index.html>.